IREDELL COUNTY HEALTH DEPARTMENT

STATESVILLE 704-878-5305 MOORESVILLE 704-664-5281

IMPROVEMENT PERMIT / AUTHORIZATION TO CONSTRUCT / OPERATION PERMIT / EXISTING SYSTEM INSPECTION

PERMIT# 7904 PIN# 3794611170 DATE 3 29 99

OWNER OR CONTRACTOR Silverwave Prop PHONE: Business 704 532 6527 Home

ADDRESS 5551 Monroe Rd Charlotte NC

LOCATION Gobb Road on Left

SUBDIVISION Featherstone BLOCK / SECTION LOT #4 LOT AREA .59 SITE CLASS PS DESIGN FLOW 360 L.T.A.R. .3

Septic Tank 500 Gallons; STB Date

Pump Tank: Gallons; PT Date

Pump Make: Model Serial No.

Nitrification Field: No. Fields 1 ~~Square Feet~~ 1200 ~~Linear Feet~~ 300 25% Red

No. Lines 3 Trench Width 36" Max Trench Bottom Depth 36"

☒ New System ☐ Repair System Type: I, II, III, IV, V, VI

System Description: 25% Reduction

Repair System Description ~~25~~ 50% Reduction / Pump

Maintenance Agreement Required: ☐ Yes ☒ No

~~Gravel~~ Depth Sand 6"

☐ House/Mod. Home No. Bedrooms 3

☒ Mobile Home No. Bathrooms 2

☐ Business No. Employees

☐ Other

☐ Slab ☒ Crawl Space ☐ Basement w/plumbing ☐ Basement wo/plumbing


Water Supply: ☒ Individual ☐ Public ☐ Community WELL

Comments/Conditions: 50 Chamber OR 30 HDS SECTIONS


100 Ft Well SetBack

Comments/Conditions

INITIAL SITE SKETCH

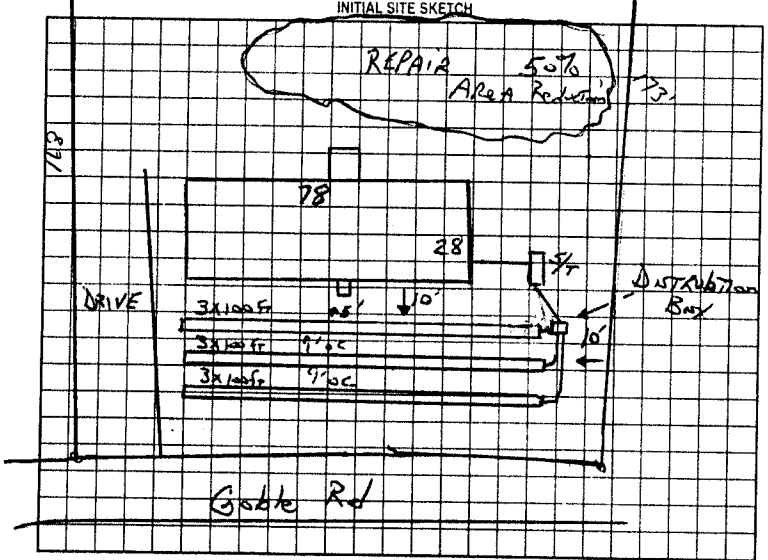

AS BUILT SKETCH

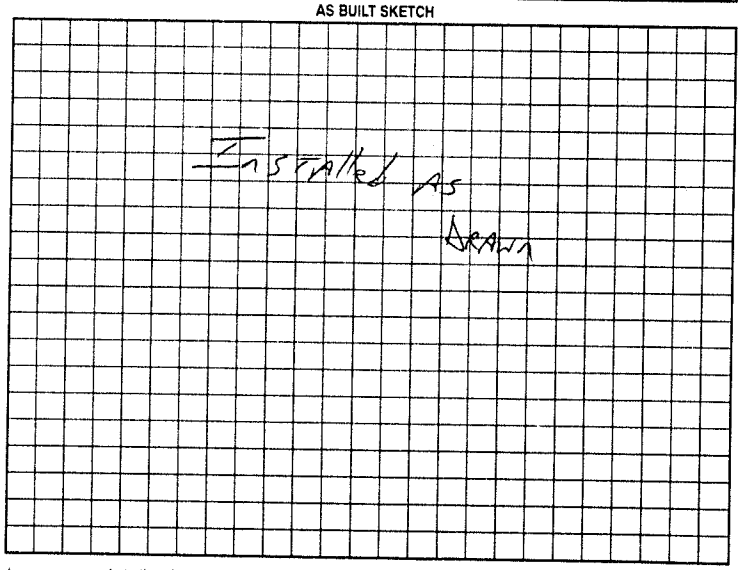

Permit can be suspended or revoked if any false information is supplied toward securing the permit/any unauthorized changes are made to the site/any unauthorized changes are made in the installation of the system. Improvement Permit with plat valid without expiration. Improvement Permit with site plan valid for sixty months. Authorization to Construct is valid for a period equal to that of Improvement Permit – not to exceed sixty months.

Signed: James J Barkley date 330-99 Installed by: A1 Backhoe

Improvement Permit by: L. Potter date 3-29-99 Operation Permit by: L Potter date June 2 99

Authorization to Construct by: L Potter date 3 29 99 Existing System Inspection by: date

HEALTH DEPT. COPY. WHITE OWNER COPY (FINAL) YELLOW OWNER COPY (INITIAL) PINK