10 Am AI

IREDELL COUNTY HEALTH DEPARTMENT

STATESVILLE 704-878-5305 MOORESVILLE 704-664-5281

IMPROVEMENT PERMIT / AUTHORIZATION TO CONSTRUCT / OPERATION PERMIT / EXISTING SYSTEM INSPECTION

PERMIT# 79013 PIN# 3794611170 DATE 3-29-99

OWNER OR CONTRACTOR Silver Wade Pump PHONE: Business 7045326527 Home

ADDRESS 5551 Monroe Rd Charlotte NC

LOCATION Featherstone off Gable Rd

SUBDIVISION Featherstone BLOCK / SECTION LOT# 3 LOT AREA .55 SITE CLASS. P5 DESIGN FLOW 360 L.T.A.R. .3

Septic Tank: 1000 Gallons; STB 1012 Date 4-9-2000
Pump Tank: Gallons; PT Date
Pump Make: Model Serial No.
Nitrification Field: No Fields 1 Square Feet 1200 Linear Feet 300
No Lines 4 Trench Width 36" Max Trench Bottom Depth 36" Gravel Depth 3 And 6"

☒ New System ☐ Repair System Type: I. II. III. IV. V. VI
System Description: 25% Reduction Gravity
Repair System Description: 25% Reduction / Pump
Maintenance Agreement Required: ☐ Yes ☒ No

☐ House/Mod. Home ☒ Mobile Home ☐ Business ☐ Other
No. Bedrooms 3 No. Bathrooms 2 No. Employees


☐ Slab ☒ Crawl Space ☐ Basement w/plumbing ☐ Basement wo/plumbing

Water Supply: ☒ Individual ☐ Public ☐ Community
WELL


Comments/Conditions: 50 chambers or 30 HDS sections
Repair may require 50% Reduction & Pump

Comments/Conditions:

INITIAL SITE SKETCH

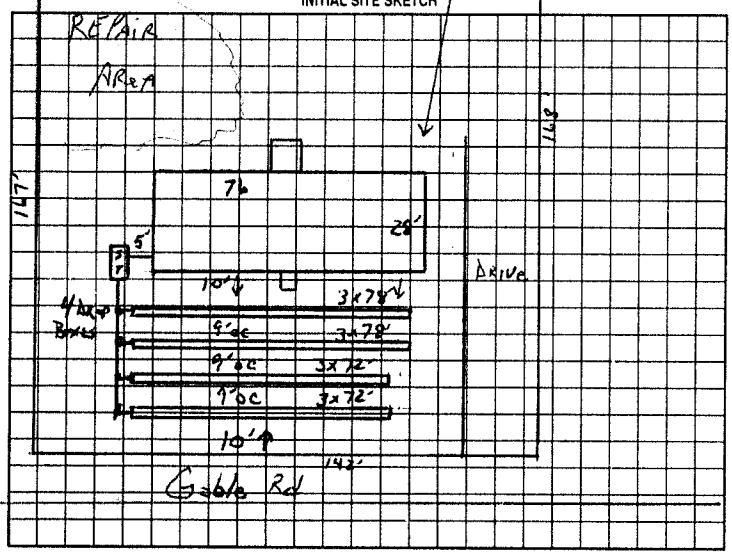

AS BUILT SKETCH

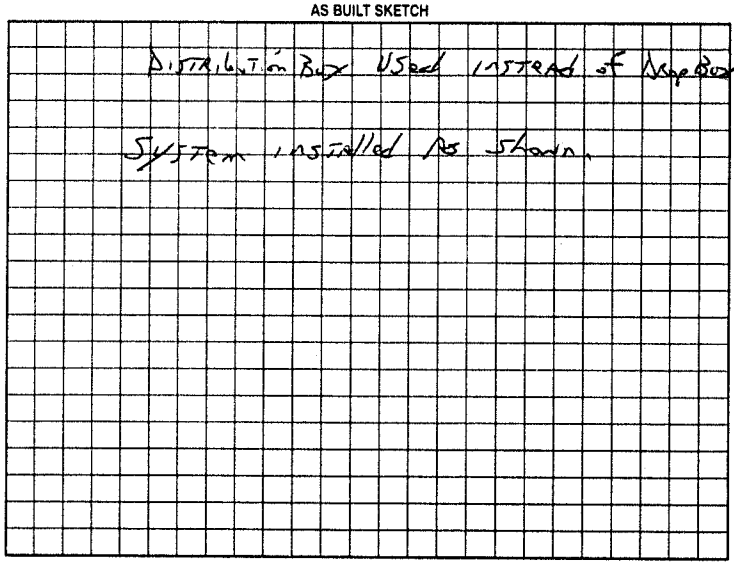

Permit can be suspended or revoked if any false information is supplied toward securing the permit/any unauthorized changes are made to the site/any unauthorized changes are made in the installation of the system. Improvement Permit with plat valid without expiration. Improvement Permit with site plan valid for sixty months. Authorization to Construct is valid for a period equal to that of Improvement Permit -- not to exceed sixty months.

Signed: James L Bartlett date 3-30-99

Improvement Permit by: Jc Potter date 3-29-99

Authorization to Construct by: Jc Potter date 3-29-99

Installed by: Al Brackee

Operation Permit by: Jc Potter date 4-24-2000

Existing System Inspection by: date

HEALTH DEPT COPY: WHITE OWNER COPY (FINAL): YELLOW OWNER COPY (INITIAL): PINK