IREDELL COUNTY HEALTH DEPARTMENT

STATESVILLE 704-878-5305 MOORESVILLE 704-664-5281

IMPROVEMENT PERMIT / AUTHORIZATION TO CONSTRUCT / OPERATION PERMIT / EXISTING SYSTEM INSPECTION

DATE 3-26-99

PERMIT# 79012 PIN# 3794611170

OWNER OR CONTRACTOR Silverwave Prop PHONE: Business 7045326527 Home

ADDRESS 5551 Monroe Rd Charlotte NC

LOCATION Island Ford ⓛ Cobble on Left ¼ mile

SUBDIVISION Featherstone BLOCK / SECTION LOT #2 LOT AREA .62 Ac SITE CLASS PS DESIGN FLOW 360 L.T.A.R. .3

Septic Tank: 1000 Gallons: STB 1012 Date 6 15 99

Pump Tank: Gallons; PT Date

Pump Make: Model Serial No.

Nitrification Field: No Fields 1 Square Feet 1440 1200 Linear Feet 400 Lft 300 ft

No Lines 4 Trench Width 36" Max Trench Bottom Depth 36" Gravel Depth Sand 6"

☒ New System ☐ Repair System Type: I. II (III) IV. V. VI

System Description: 25% Reduction Gravity

Repair System Description: 25-50% Reduction Gravity

Maintenance Agreement Required: ☐ Yes ☒ No

☐ House/Mod. Home ☒ Mobile Home ☐ Business ☐ Other

No. Bedrooms 3 No. Bathrooms 2 No. Employees


☐ Slab ☒ Crawl Space ☐ Basement w/plumbing ☐ Basement wo/plumbing

Water Supply: ☒ Individual ☐ Public ☐ Community WELL


Comments/Conditions: Install lines on Contour Repair may require 50% Reduction System 162 Ft

Comments/Conditions: Sixty Ft. Home ~~may~~ Suggested

INITIAL SITE SKETCH

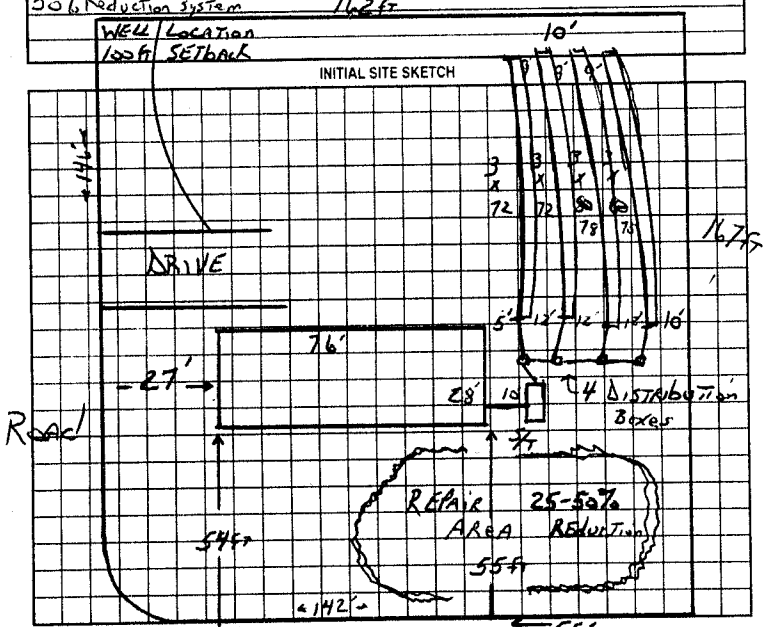

AS BUILT SKETCH

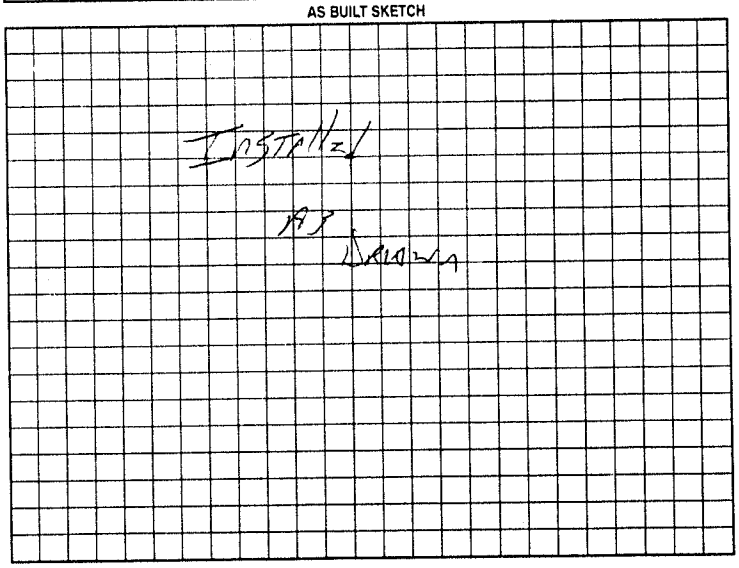

Permit can be suspended or revoked if any false information is supplied toward securing the permit/any unauthorized changes are made to the site/any unauthorized changes are made in the installation of the system. Improvement Permit with plat valid without expiration. Improvement Permit with site plan valid for sixty months. Authorization to Construct is valid for a period equal to that of Improvement Permit – not to exceed sixty months.

Signed: [signature] date 3-30-99

Improvement Permit by: J. Potter date 3-26-99

Authorization to Construct by: J. Potter date 3-26-99

Installed by: Al Backhus

Operation Permit by: J. Potter date 8.18.99

Existing System Inspection by: date

HEALTH DEPT COPY: WHITE OWNER COPY (FINAL) YELLOW OWNER COPY (INITIAL): PINK