45616

IREDELL COUNTY HEALTH DEPARTMENT

STATESVILLE 704-878-5305 MOORESVILLE 704-664-5281

IMPROVEMENT PERMIT / CERTIFICATE OF COMPLETION / OPERATION PERMIT / EXISTING SYSTEM INSPECTION

TAX MAP NO. 85-A-39

PROPERTY DESCRIPTION NO. 15434 DATE 6-28-93 PHONE: Business Home

OWNER OR CONTRACTOR J. Acid Gray

ADDRESS

LOCATION I-40 W TR old mtn Rd TL New Sterling Rd on Road on left Past New Sterling Ch

SUBDIVISION BLOCK / SECTION LOT LOT AREA acreage SITE CLASS. P.S. L.T.A.R. 1.4 gal/sq ft/day

Water Supply: ☑ Individual ☐ Community ☐ Public

Septic Tank: 1000 Gallons; STB 358 Date 3-23-93

Pump Tank: Gallons; PT Date

Nitrification Field: No Fields 1 Square Feet 900 Linear Feet 300

No Lines 3 Trench Width 36 Trench Depth 24 Gravel Depth 12

☑ New System ☐ Repair System Type: I, II, III, IV, V, VI

System Description: Con. Gravity

Repair System Description Con. Gravity

Maintenance Agreement Required: ☐ Yes ☑ No

☑ House/Mod. Home No. Bedrooms 3

☐ Mobile Home No. Bathrooms 2

☐ Business No. Employees

☐ Other

☐ Slab ☑ Crawl Space ☐ Basement w/plumbing ☐ Basement wo/plumbing

Garbage Disposal: ☐ Yes ☑ No


Auto. Dishwasher: ☑ Yes ☐ No

Auto. Washing Machine: ☐ Yes ☐ No


Other

Comments

INITIAL SITE SKETCH

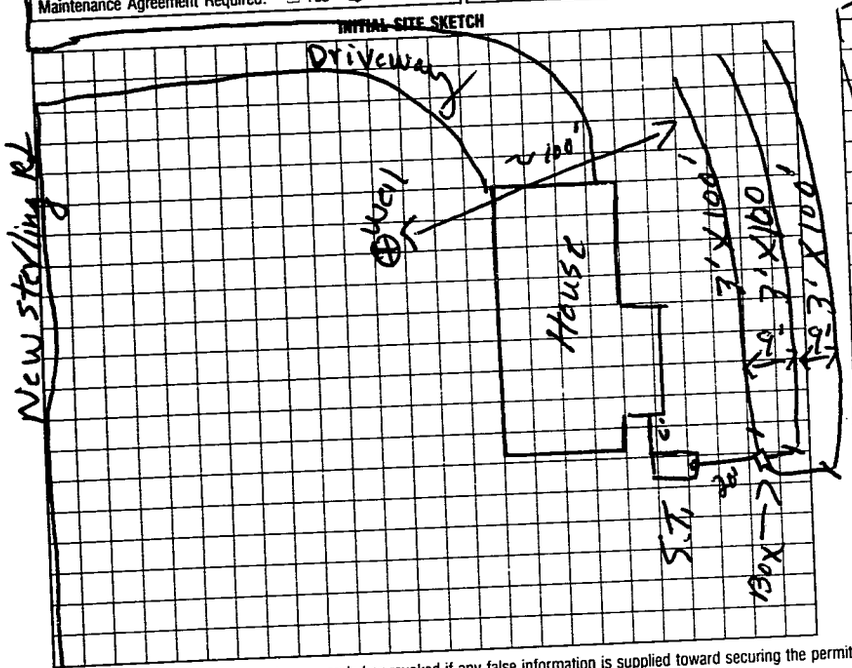

AS BUILT SKETCH

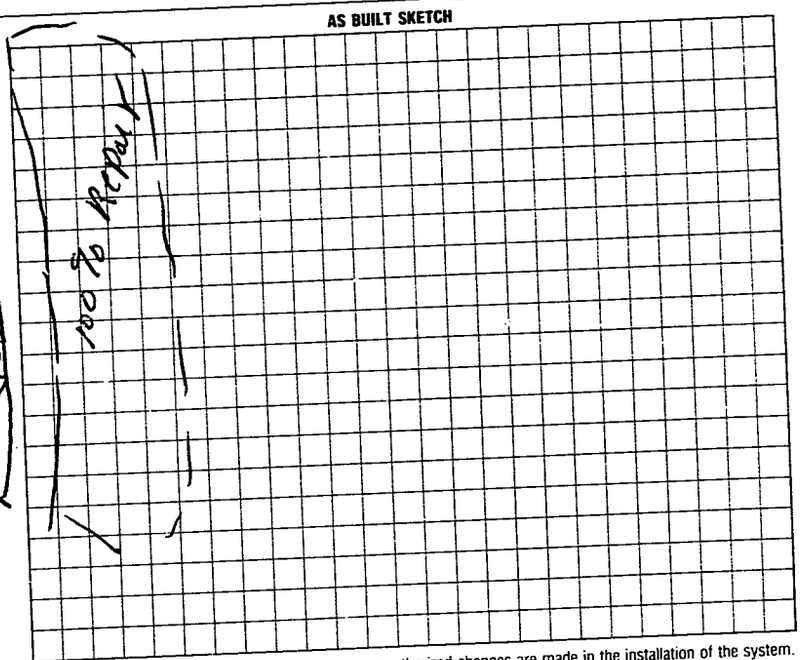

I understand that this permit can be suspended or revoked if any false information is supplied toward securing the permit/any unauthorized changes are made to the site/any unauthorized changes are made in the installation of the system. Improvement Permit is valid for 60 months from date of issuance.

Signed:

Improvement Permit by: Steve Hedrick date 11-6-92

Existing System Inspection by: date

Installed by: James Hunter

Certificate of Completion by: R.C. Moore date 6-28-93

Operation Permit by: date

HEALTH DEPT. COPY: WHITE INSPECTION COPY (FINAL): GREEN OWNER COPY (FINAL): YELLOW INSPECTION COPY (INITIAL): PINK OWNER COPY (INITIAL): GOLD