IREDELL COUNTY HEALTH DEPARTMENT

STATESVILLE 704-878-5305 MOORESVILLE 704-664-5281

IMPROVEMENT PERMIT / AUTHORIZATION TO CONSTRUCT / OPERATION PERMIT / EXISTING SYSTEM INSPECTION

PERMIT# 89574 PIN# 3794611170 pT DATE June 17 2000

OWNER OR CONTRACTOR Piedmont Housing PHONE: Business 528-7120 Home

ADDRESS 1040 CHARLotte Hwy TROUTMAN, NC

LOCATION Old MT Rd Nth ② Island Ford ② Cobble ② MARBLEstone 2nd on Right FACing TANBRidge

SUBDIVISION FEATHERSTONE BLOCK / SECTION 2 LOT 33 LOT AREA .69 Ac SITE CLASS P3 DESIGN FLOW 360 L.T.A.R. .25 gal/day

Septic Tank: 1000 Gallons; STB 1012 Date 4 21 00

Pump Tank: Gallons; PT Date

Pump Make: Model Serial No.

Nitrification Field: No Fields 1 Square Feet 1440 Linear Feet 360

No Lines 4 Trench Width 36" Max Trench Bottom Depth 36" Gravel Depth N/A

☒ New System ☐ Repair System Type: I, II, ⓘ, IV, V, VI

System Description: GRAVITY 25% Reduction

Repair System Description: 25 50% Red. Pump possible

Maintenance Agreement Required: ☐ Yes ☒ No

☐ House/Mod. Home ☒ Mobile Home ☐ Business ☐ Other

No. Bedrooms 3 No. Bathrooms 2 No. Employees

☐ Slab ☒ Crawl Space ☐ Basement w/plumbing ☐ Basement wo/plumbing


Water Supply: ☒ Individual ☐ Public ☐ Community

WELL


Comments:/Conditions: 60 CHAMBERS OR 36 HDS SECTIONS
INSTALL on CONTOUR. DISTRIBUTION BOX W/SPEED LEVELS
FEED TOP 2 60FT LINES TOGETHER LAST TWO SEPERATE
KEEP WELLS 100FT OR MAX FEASIBLE DISTANCE FROM SYSTEM (50FT MIN)

Comments:/Conditions:

INITIAL SITE SKETCH

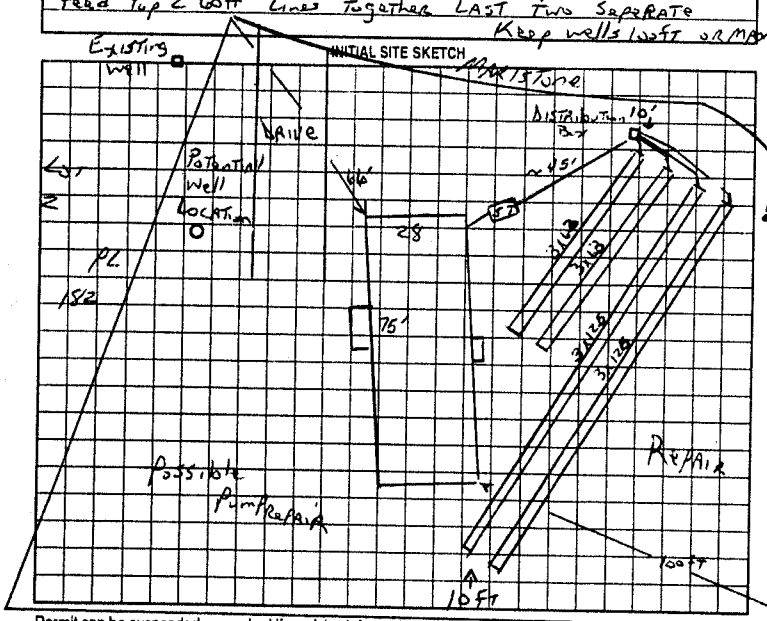

AS BUILT SKETCH

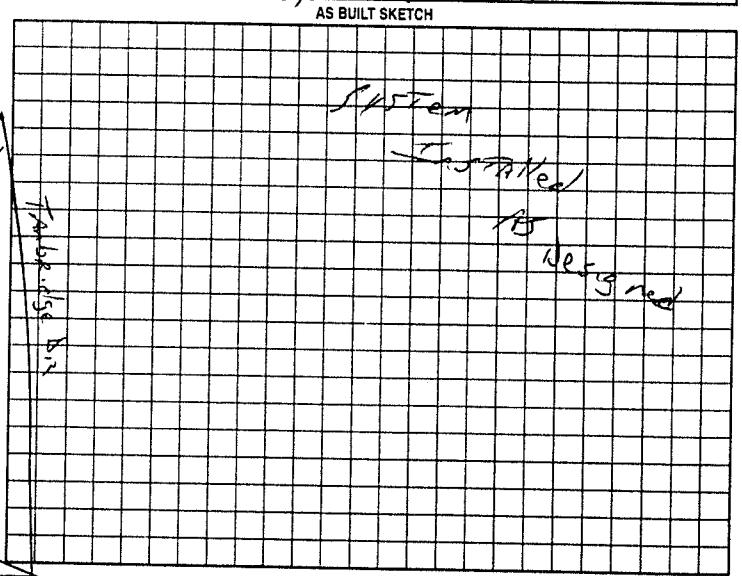

Permit can be suspended or revoked if any false information is supplied toward securing the permit/any unauthorized changes are made to the site/any unauthorized changes are made in the installation of the system. Improvement Permit with plat valid without expiration. Improvement Permit with site plan valid for sixty months. Authorization to Construct is valid for a period equal to that of Improvement Permit – not to exceed sixty months.

Signed: Chad R. Fox date 6-26-00 Installed by: Tommy Frye

Improvement Permit by: J. C Potter date June 17 2000 Operation Permit by: J. C Potter date June 29 2000

Authorization to Construct by: J. C Potter date June 17 2000 Existing System Inspection by: date

HEALTH DEPT. COPY: WHITE OWNER COPY (FINAL): YELLOW OWNER COPY (INITIAL): PINK