Void Permit issued on 10-25

IREDELL COUNTY HEALTH DEPARTMENT

STATESVILLE 704-878-5305 MOORESVILLE 704-664-5281

IMPROVEMENT PERMIT / AUTHORIZATION TO CONSTRUCT / OPERATION PERMIT / EXISTING SYSTEM INSPECTION

PERMIT# 84269 PIN# 3794611170 DATE OCT 26 99

OWNER OR CONTRACTOR Julie Moose PHONE: Business Home 871 9424

ADDRESS 157 Westridge Dr.

LOCATION Old Mt Rd ② Island Ford ③ Cable Rd ④ MARISTOWN ⑤ 1st Drive Lot on Right in Cul De Sac

SUBDIVISION Featherstone BLOCK / SECTION 11 LOT 31 LOT AREA 1.10 Ac SITE CLASS PS DESIGN FLOW 360 L.T.A.R. .3

Septic Tank: 1000 Gallons; STB 1007 Date 8-30-99
Pump Tank: Gallons; PT Date
Pump Make: Model Serial No.
Nitrification Field: No Fields 1 Square Feet 1200 Linear Feet 400
No Lines 5 Trench Width 36" Max Trench Bottom Depth 24"

☒ New System ☐ Repair System Type: I. II. III. IV. V. VI
System Description: Conv. Gravity
Repair System Description: 25% Gravity
Maintenance Agreement Required: ☐ Yes ☒ No
Gravel Depth 12"


☐ House/Mod. Home No. Bedrooms 3
☒ Mobile Home 4W No. Bathrooms 2
☐ Business No. Employees
☐ Other
☐ Slab ☒ Crawl Space ☐ Basement w/plumbing ☐ Basement wo/plumbing

Water Supply: ☒ Individual ☐ Public ☐ Community WELL


Comments:/Conditions: Install on Contour Surface Diversion Ditch
24" Max Trench Depth
Locate Tank To Insure Trench Depth
Keep 100 Ft From Septic System or Max Feasible Distance (50 Ft min)

Comments: Conditions

INITIAL SITE SKETCH

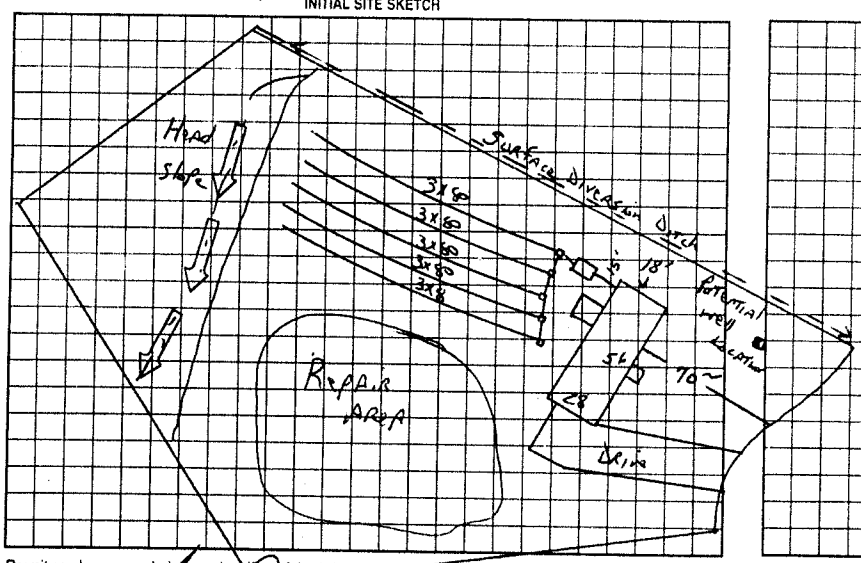

AS BUILT SKETCH

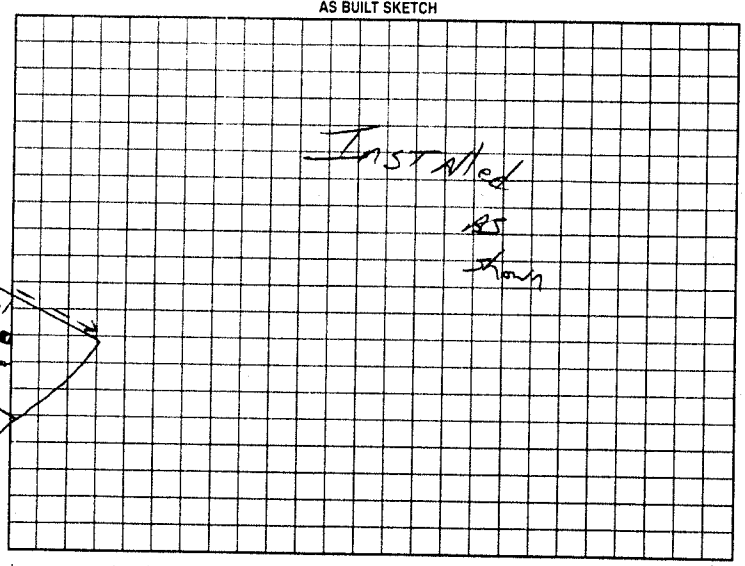

Permit can be suspended or revoked if any false information is supplied toward securing the permit/any unauthorized changes are made to the site/any unauthorized changes are made in the installation of the system. Improvement Permit with plat valid without expiration. Improvement Permit with site plan valid for sixty months. Authorization to Construct is valid for a period equal to that of Improvement Permit – not to exceed sixty months.

Signed: 10/26/99 date

Improvement Permit by: Jc Potter date Oct 26 99

Authorization to Construct by: Jc Potter date Oct 26 99

Installed by: Billy Adams

Operation Permit by: Jc Potter date Dec 9 99

Existing System Inspection by: date

HEALTH DEPT COPY: WHITE OWNER COPY (FINAL): YELLOW OWNER COPY (INITIAL): PINK