IREDELL COUNTY HEALTH DEPARTMENT

STATESVILLE 704-878-5305 MOORESVILLE 704-664-5281

IMPROVEMENT PERMIT / AUTHORIZATION TO CONSTRUCT / OPERATION PERMIT / EXISTING SYSTEM INSPECTION

PERMIT# 88472 114207 PIN# ~~3794 41 470~~ 3794-50-1635 DATE July 11, 2000

OWNER OR CONTRACTOR Silver Wave Prop. PHONE: Business 532 6527 Home

ADDRESS 5551 Monroe Rd Charlotte

LOCATION Old Mt Rd N to L Island Ford L Goble Rd L Maristone 3rd Lot on Left

SUBDIVISION Featherstone BLOCK / SECTION II LOT 6 LOT AREA 1.69 SITE CLASS. B DESIGN FLOW 360 L.T.A.R. .25

Septic Tank: 1000 Gallons; STB 1012 Date 1-5-03
Pump Tank: Gallons; PT Date
Pump Make: Model Serial No.
Nitrification Field: No Fields 1 Square Feet 1440 eq. Linear Feet 400
No Lines 4@95 each Trench Width 36 Max Trench Bottom Depth 18-24" Gravel Depth N/A

☒ New System ☐ Repair System Type: I, II, (III), IV, V, VI
System Description: Gravity 25% Reduction
Repair System Description: Gravity 25-50% Red.
Maintenance Agreement Required: ☐ Yes ☒ No


☐ House/Mod. Home No. Bedrooms 3
☒ Mobile Home SW No. Bathrooms 2
☐ Business No. Employees
☐ Other
☐ Slab ☒ Crawl Space ☐ Basement w/plumbing ☐ Basement wo/plumbing

Water Supply: ☒ Individual ☐ Public ☐ Community Well


Comments/Conditions: Install contour 60 Chambers or ~~30 HDS~~ sections. 18-24" Trench Depth 36 HDS

Comments/Conditions: Poly Lok Filter - ST media Installed - 64 Infiltrator Chambers Installed

INITIAL SITE SKETCH

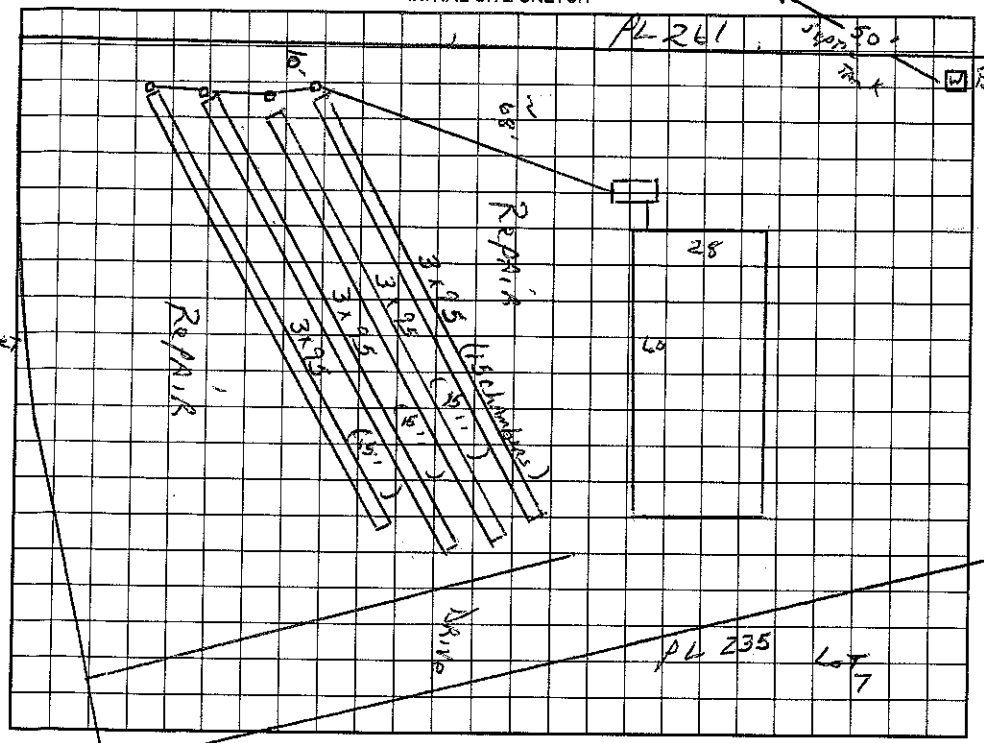

AS BUILT SKETCH

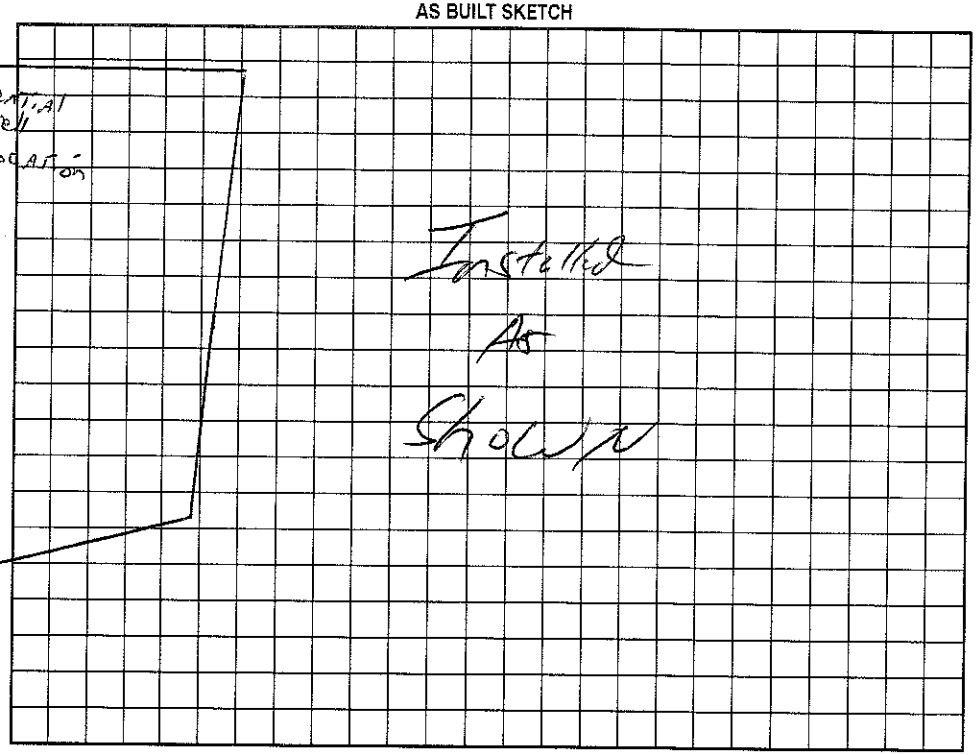

Permit can be suspended or revoked if any false information is supplied toward securing the permit/any unauthorized changes are made to the site/any unauthorized changes are made in the installation of the system. Improvement Permit with plat valid without expiration. Improvement Permit with site plan valid for sixty months. Authorization to Construct is valid for a period equal to that of Improvement Permit – not to exceed sixty months.

Signed: James J Buckley date 7-11-2000 Installed by: Craig Thompson

Improvement Permit by: J.C. Potter date July 11, 2000 Operation Permit by: William G Johnson date 7/16/03

Authorization to Construct by: J.C. Potter date July 11, 2000 Existing System Inspection by: date

HEALTH DEPT. COPY: WHITE OWNER COPY (FINAL): YELLOW OWNER COPY (INITIAL): PINK