IREDELL COUNTY HEALTH DEPARTMENT

STATESVILLE 704-878-5305 MOORESVILLE 704-664-5281

IMPROVEMENT PERMIT / AUTHORIZATION TO CONSTRUCT / OPERATION PERMIT / EXISTING SYSTEM INSPECTION

PERMIT# 165719 PIN# 3794-50-1635 DATE 4-25-11

OWNER OR APPLICANT Jacquelin Gomez PHONE: Business _____ Home 704-682-2610

ADDRESS 119 Maristelne

LOCATION Old Mtn Rd (N) 700 (L) on Island Ford Rd (L) Gobble Rd, (L) Maristone Dr. 3rd house on left

SUBDIVISION Featherstone BLOCK / SECTION _____ LOT 6 LOT AREA .69 SITE CLASS. 85 DESIGN FLOW 360 L.T.A.R. .25

Septic Tank: 1000 Gallons: STB ex Date ex

Pump Tank: _____ Gallons: PT _____ Date _____

Pump Make: _____ Model _____ Serial No. _____

Nitrification Field: No Fields ____ Square Feet ex Linear Feet 48

No Lines 4 ex Trench Width 36 Max Trench Bottom Depth 18-24 (ex) Gravel Depth 8/in ☑ Gravity ☐ Pressure

☒ New System ☐ Repair ☐ Expansion System Type: I II (III) IV V VI

System Description: Gravity 25% Reduction

Repair System Description: Gravity 25-50% Reduction

Maintenance Agreement Required: ☐ Yes ☒ No

☐ House/Mod. Home ☒ Mobile Home ☐ Business ☐ Other

No. Bedrooms 3 No. Persons ____ No. Employees ____


Water Supply: ☒ Individual ☐ Public ☐ Community

☐ Slab ☒ Crawl Space ☐ Basement w/plumbing ☐ Basement wo/plumbing


Comments:/Conditions:

Comments:/Conditions:

INITIAL SITE SKETCH

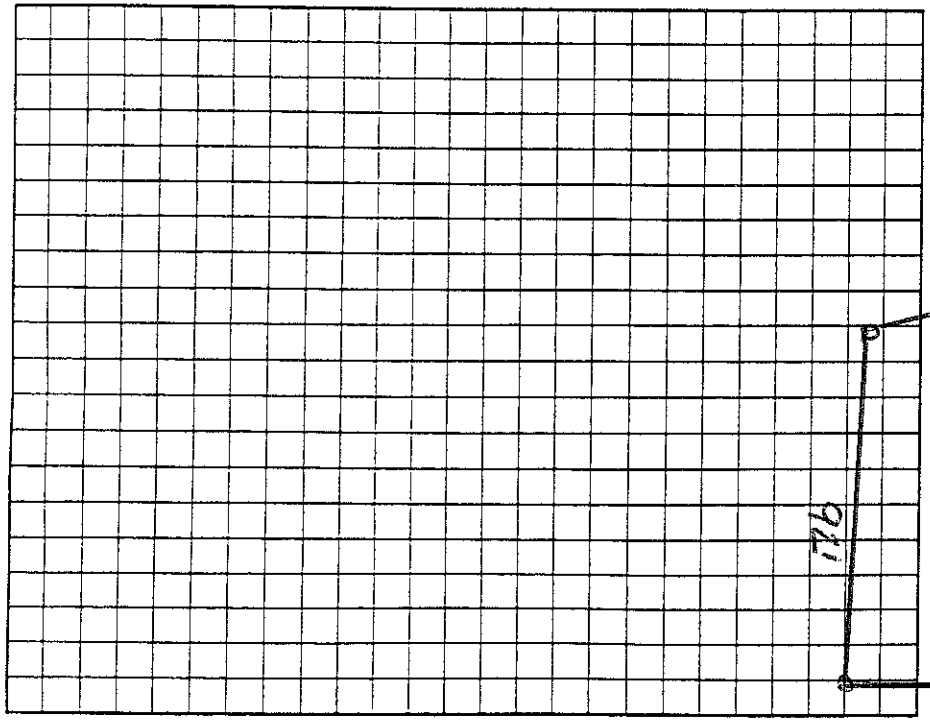

AS BUILT SKETCH

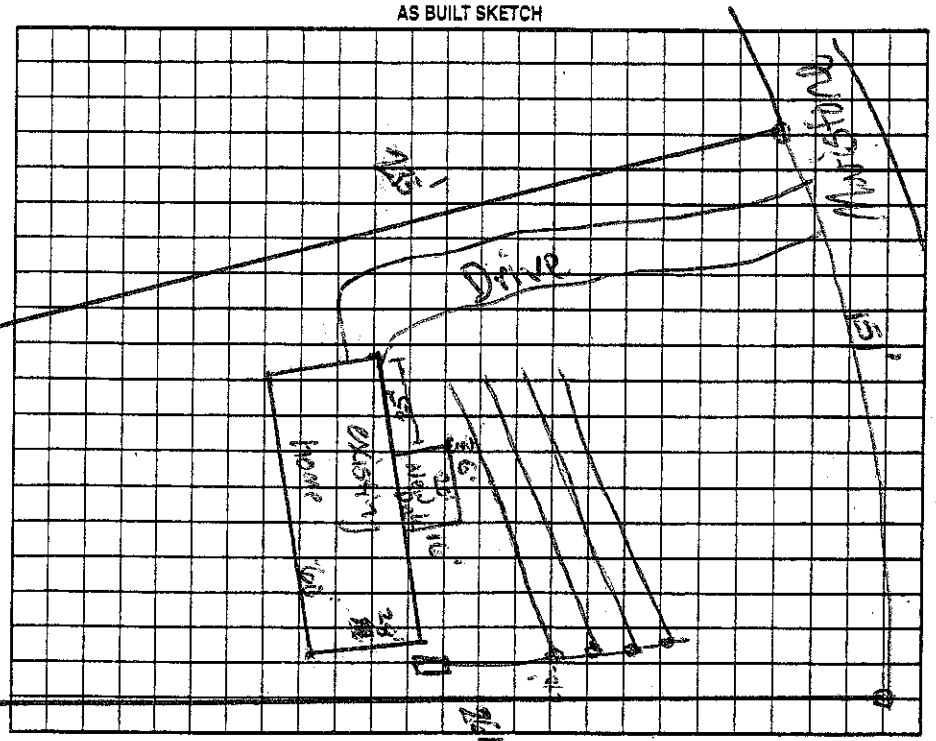

Permit can be suspended or revoked if any false information is supplied toward securing the permit/any unauthorized changes are made to the site/any unauthorized changes are made in the installation of the system. Improvement Permit with plat valid without expiration ☐ Improvement Permit with site plan valid for sixty months ☐ Authorization to Construct is valid for a period equal to that of Improvement Permit – not to exceed sixty months.

Signed: Jacquelin S Gomez date 4/26/11

Improvement Permit by: _____ date _____

Authorization to Construct by: _____ date _____

Installed by: _____

Operation Permit by: _____ date _____

Existing System Inspection by: _____ date 4-25-11

HEALTH DEPT. COPY: WHITE OWNER COPY (FINAL): YELLOW OWNER COPY (INITIAL): PINK