IREDELL COUNTY HEALTH DEPARTMENT

STATESVILLE 704-878-5305 MOORESVILLE 704-664-5281

IMPROVEMENT PERMIT / AUTHORIZATION TO CONSTRUCT / OPERATION PERMIT / EXISTING SYSTEM INSPECTION

PERMIT# 89194 PIN# 3794611170 pT DATE July 18, 2000

OWNER OR CONTRACTOR Silverwave Prop PHONE: Business 532 6527 Home

ADDRESS 5551 Monroe Rd Charlotte

LOCATION NTL Old Mt Rd (L) Island Ford (L) Gobble Rd (L) Maristone 1st Right To end Straight

SUBDIVISION Featherstone BLOCK / SECTION II LOT 30 LOT AREA .77 SITE CLASS. B5 DESIGN FLOW 360 L.T.A.R. .25

Septic Tank: 1000 Gallons; STB 1012 Date 11-1-00

Pump Tank: Gallons; PT Date

Pump Make: Model Serial No.

Nitrification Field: No Fields 1 Square Feet 1440 Linear Feet 360

No Lines 4 Trench Width 36" Max Trench Bottom Depth 30"

☒ New System ☐ Repair System Type: I, II (III) IV, V, VI

System Description: GRAVITY 25% Reduction

Repair System Description: Pump 25-50% Red

Maintenance Agreement Required: ☐ Yes ☒ No

Gravel Depth N/A ☐ Slab ☒ Crawl Space ☐ Basement w/plumbing ☐ Basement wo/plumbing

☐ House/Mod. Home No. Bedrooms 3

☒ Mobile Home 1 W No. Bathrooms 2

☐ Business No. Employees

☐ Other


Water Supply: ☒ Individual ☐ Public ☐ Community WELL

Comments/Conditions: INSTALL 60 CHAMBERS OF 36 HDS SECTIONS LOCATE WELL 100FT OR MAX FEASIBLE DISTANCE FROM SEPTIC *30" TRENCH DEPTH*


Comments /Conditions: ① KEEP ALL DRAINS AWAY FROM DRAINFIELD/REPAIR AREAS ② NO CUTTING OR FILL OVER DRAINFIELD AREAS ③ PUMP SEPTIC TANK EVERY 3-5 YRS.

1" = 50ft

INITIAL SITE SKETCH

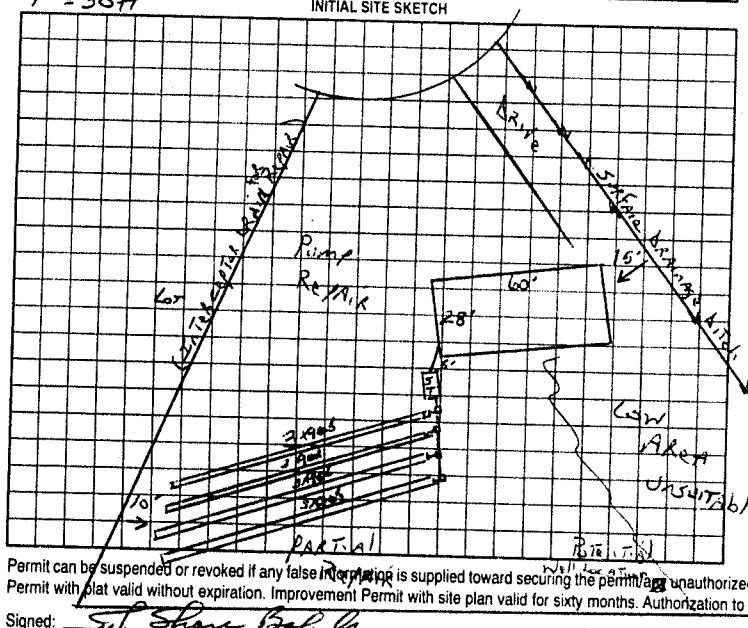

AS BUILT SKETCH

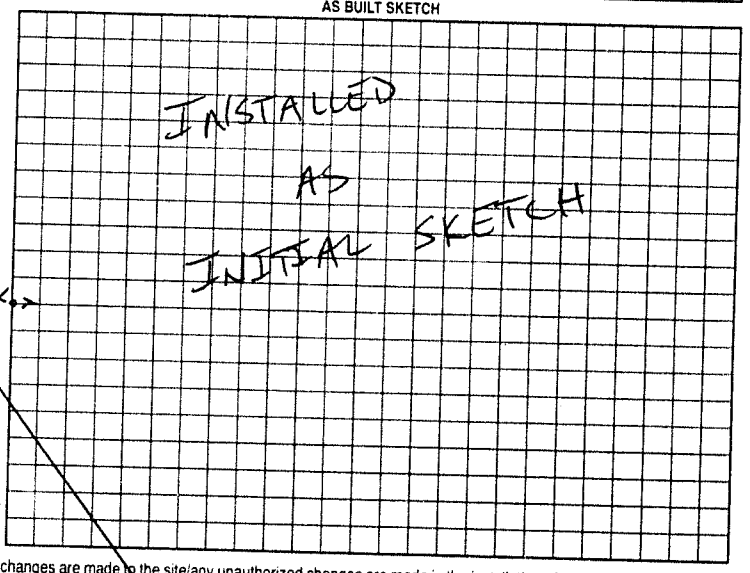

Permit can be suspended or revoked if any false information is supplied toward securing the permit/any unauthorized changes are made to the site/any unauthorized changes are made in the installation of the system. Improvement Permit with plat valid without expiration. Improvement Permit with site plan valid for sixty months. Authorization to Construct is valid for a period equal to that of Improvement Permit – not to exceed sixty months.

Signed: Sat Shaw Bahula date

Improvement Permit by: Joe Potter date July 18 2000

Authorization to Construct by: Joe Potter date July 18 2000

Installed by: A-1 BACKHOE

Operation Permit by: Sat Shaw date 2/20/01

Existing System Inspection by: date

HEALTH DEPT COPY: WHITE OWNER COPY (FINAL) YELLOW OWNER COPY (INITIAL) PINK