IREDELL COUNTY HEALTH DEPARTMENT

STATESVILLE 704-878-5305 MOORESVILLE 704-664-5281

IMPROVEMENT PERMIT / AUTHORIZATION TO CONSTRUCT / OPERATION PERMIT / EXISTING SYSTEM INSPECTION

PERMIT# 88473 PIN# 3794611170 PT DATE July 19, 2000

OWNER OR CONTRACTOR Silverwave Prop PHONE: Business 532 6527 Home

ADDRESS 5551 Monroe Rd Charlotte

LOCATION Old Mt Rd Nth ⑤ Island Ford ⑥ Cable Rd (L), Marstone 4th Lot on Left

SUBDIVISION Featherstone BLOCK / SECTION II LOT 7 LOT AREA .69 SITE CLASS PS DESIGN FLOW 360 L.T.A.R. .25

Septic Tank: 1000 Gallons; STB 794 Date 2-20-01
Pump Tank: Gallons; PT Date
Pump Make: Model Serial No.
Nitrification Field: No Fields 1 Square Feet 1440 Linear Feet 480
No Lines 4 Trench Width 36" Max Trench Bottom Depth 24" Gravel Depth 12"

☒ New System ☐ Repair System Type: I ◐ IV, V, VI
System Description: Gravity Conventional
Repair System Description: Gravity Reduction 25 50%
Maintenance Agreement Required: ☐ Yes ☒ No

☐ House/Mod. Home ☒ Mobile Home ☐ Business ☐ Other
No. Bedrooms 3 No. Bathrooms 2 No. Employees


☐ Slab ☒ Crawl Space ☐ Basement w/plumbing ☐ Basement wo/plumbing

Water Supply: ☒ Individual ☐ Public ☐ Community
well


Comments/Conditions: Remove field Terrace Locate home As Close To Rear setback As possible. Keep well 100 ft ~~from~~ * 24" Trench Depth *

Comments/Conditions
Max Feasible distance (50ft min) from Septic System
Installed 5 lines (total 480sf)

INITIAL SITE SKETCH

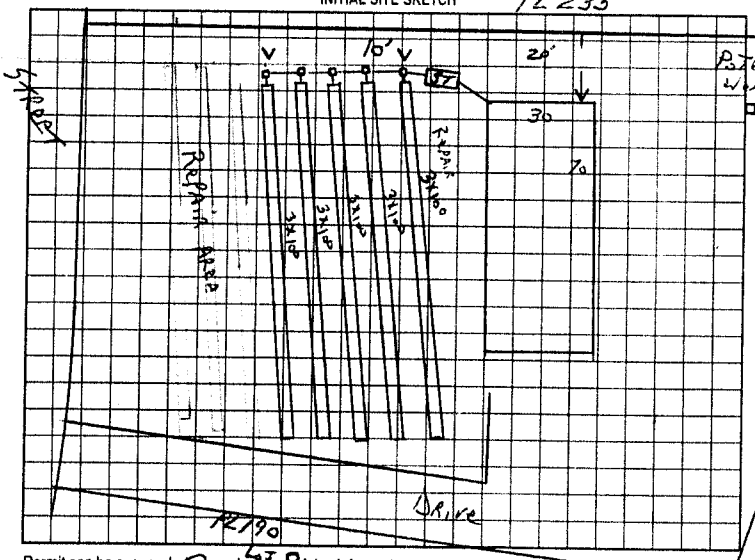

AS BUILT SKETCH

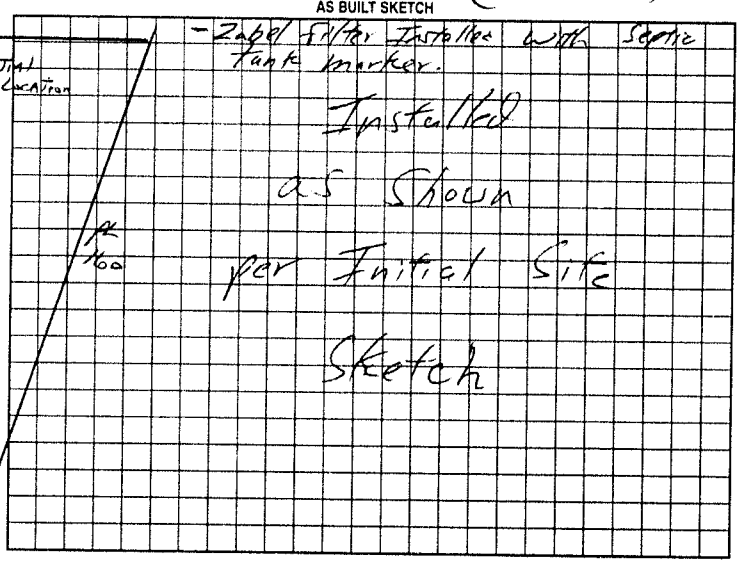

Permit can be suspended or revoked if any false information is supplied toward securing the permit/any unauthorized changes are made to the site/any unauthorized changes are made in the installation of the system. Improvement Permit with plat valid without expiration. Improvement Permit with site plan valid for sixty months. Authorization to Construct is valid for a period equal to that of Improvement Permit – not to exceed sixty months.

Signed: [signature] date July 20, 2000 Installed by: Ken Kellinger

Improvement Permit by: J. Potter date July 18, 2000 Operation Permit by: William C. Johnson date 10/3/01

Authorization to Construct by: J. Potter date July 18, 2000 Existing System Inspection by: date

HEALTH DEPT. COPY: WHITE OWNER COPY (FINAL): YELLOW OWNER COPY (INITIAL): PINK