IREDELL COUNTY HEALTH DEPARTMENT

STATESVILLE 704-878-5305 MOORESVILLE 704-664-5281

IMPROVEMENT PERMIT / AUTHORIZATION TO CONSTRUCT / OPERATION PERMIT / EXISTING SYSTEM INSPECTION

PERMIT# 88287 PIN# 3794 61 1170 pT DATE April 6 2000

OWNER OR CONTRACTOR Magell Eckles / Piedmont Housing PHONE: Business 872 0179 Home

ADDRESS 1270 Northside Dr Statesville

LOCATION Old MT Rd Nth (L) Island Ford (L) Cobble (L) Mansione (R) Tanbridge on Left 1st end.

SUBDIVISION Featherstone BLOCK / SECTION II LOT 28 LOT AREA .70 SITE CLASS. P5 DESIGN FLOW 480 L.T.A.R. .25

Septic Tank: 1000 Gallons; STB 1012 Date 11 29 99
Pump Tank: Gallons; PT Date
Pump Make: Model Serial No.
Nitrification Field: No Fields 1 Square Feet 1600 Linear Feet 400
No Lines 4 Trench Width 36 Max Trench Bottom Depth 30"

☑ New System ☐ Repair System Type: I. II. III. IV. V. VI
System Description: Gravity 25% Reduction
Repair System Description: Gravity 50% Reduction
Maintenance Agreement Required: ☐ Yes ☑ No
Gravel Depth N/A ☐ Slab ☑ Crawl Space ☐ Basement w/plumbing ☐ Basement wo/plumbing


☑ House/Mod. Home No. Bedrooms 3
☐ Mobile Home No. Bathrooms 2
☐ Business No. Employees
☐ Other

Water Supply: ☑ Individual ☐ Public ☐ Community
Well

Comments/Conditions: Install system shallow + on contour. Install interceptor drain above system ≈150-200ft 6" wide min. 4' deep min. Slotted corrugated pipe + fill w/gravel up to 6" of surface Run to daylight. Recommend surface diversion ditch along w/interceptor drain. Follow all setback regulations

PC 179.84


INITIAL SITE SKETCH

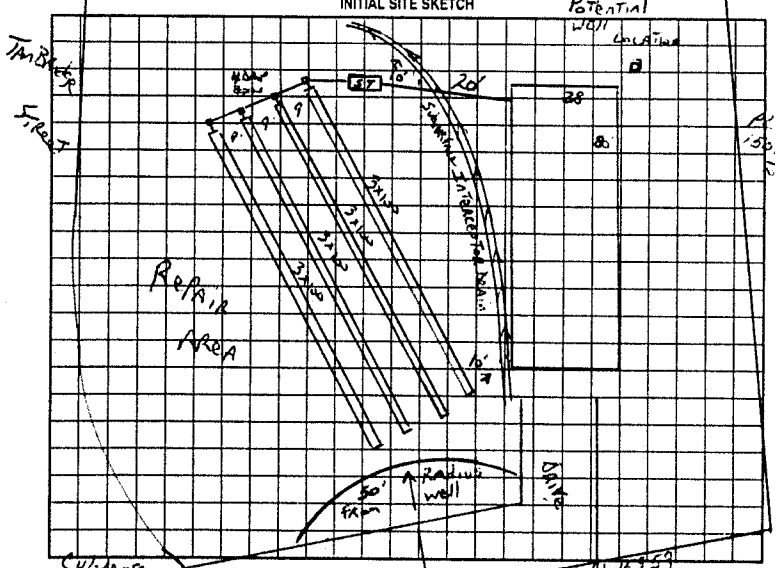

AS BUILT SKETCH

System installed As designed Except Subsurface diversion ditch

Subsurface diversion ditch was installed around back of home And exiting on the Right side along drive.

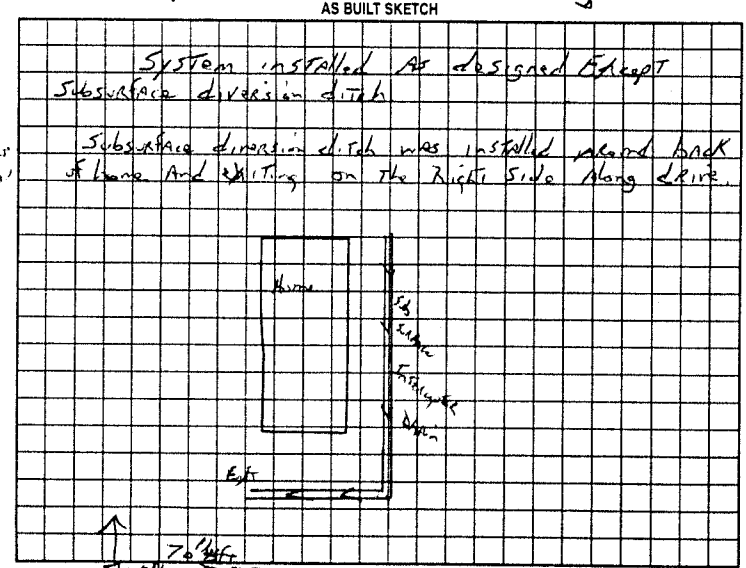

Permit can be suspended or revoked if any false information is supplied toward securing the permit/any unauthorized changes are made to the site/any unauthorized changes are made in the installation of the system. Improvement Permit with plat valid without expiration. Improvement Permit with site plan valid for sixty months. Authorization to Construct is valid for a period equal to that of Improvement Permit – not to exceed sixty months.

Signed: date 4-6-00 Installed by: Al Backy Hoe

Improvement Permit by: Joe Fotter date Apr 16 2000 Operation Permit by: Joe Fotter date April 10 2000

Authorization to Construct by: Joe Fotter date Apr 16 2000 Existing System Inspection by: date

HEALTH DEPT. COPY: WHITE OWNER COPY (FINAL) YELLOW OWNER COPY (INITIAL) PINK