DELLINGER

IREDELL COUNTY HEALTH DEPARTMENT

STATESVILLE 704-878-5305 MOORESVILLE 704-664-5281

IMPROVEMENT PERMIT / AUTHORIZATION TO CONSTRUCT / OPERATION PERMIT / EXISTING SYSTEM INSPECTION

PERMIT# 8847 PIN# 3794 61 1170 pT DATE May 9, 2000

OWNER OR CONTRACTOR Silver Wave Prop PHONE: Business 532 6527 Home

ADDRESS 5551 Monroe Rd Charlotte NC

LOCATION Old MT Rd Nth (L) Island Ford (L) Gable (L) MARISTONE, 5th LOT on Left before woods

SUBDIVISION Featherstone BLOCK / SECTION II LOT 8 LOT AREA .69 SITE CLASS PS DESIGN FLOW 360 L.T.A.R. .25

Septic Tank: 1000 Gallons: STB 794 Date 12.22.01
Pump Tank: Gallons: PT Date
Pump Make: Model Serial No.
Nitrification Field: No Fields 1 Square Feet 1440 Linear Feet 360
No Lines 4 Trench Width 36" Max Trench Bottom Depth 36" Gravel Depth N/A

☒ New System ☐ Repair System Type: I, II, III, IV, V, VI
System Description: GRAVITY 25% Reduction
Repair System Description: GRAV. III 50% Reduction
Maintenance Agreement Required: ☐ Yes ☒ No

☐ House/Mod. Home ☒ Mobile Home SW ☐ Business ☐ Other
No. Bedrooms 3 No. Bathrooms 2 No. Employees

☐ Slab ☒ Crawl Space ☐ Basement w/plumbing ☐ Basement wo/plumbing


Water Supply: ☐ Individual ☐ Public ☐ Community well

Comments/Conditions: Remove field TERRACE And Rise AT ditch
58 chambers 36 ~~chambers~~ HDS
May USE DISTRIBUTION BOX w/speed Levels
pc 190

Comments/Conditions: ZABEL FILTER + MARKER

INITIAL SITE SKETCH

Scale 1" = 40 ft

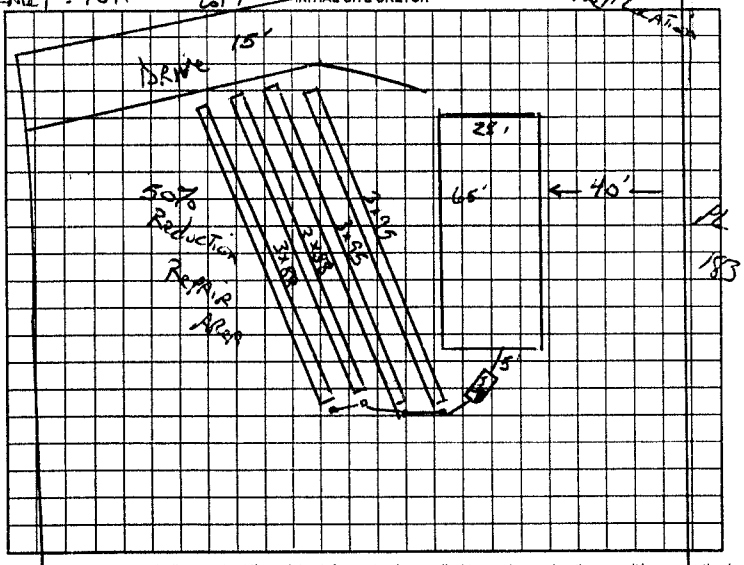

AS BUILT SKETCH

4 x 60' LINES = 360
USED 3 DEEP BOXES
+ EASY CAY

Permit can be suspended or revoked if any false information is supplied toward securing the permit/any unauthorized changes are made to the site/any unauthorized changes are made in the installation of the system. Improvement Permit with plat valid without expiration. Improvement Permit with site plan valid for sixty months. Authorization to Construct is valid for a period equal to that of Improvement Permit – not to exceed sixty months.

Signed: [signature] date 5/9/00 Installed by: DELLINGER

Improvement Permit by: J.C. Potter date May 9 2000 Operation Permit by: [signature] PS date 02.05.02

Authorization to Construct by: J.C. Potter date May 9 2000 Existing System Inspection by: date

HEALTH DEPT. COPY: WHITE OWNER COPY (FINAL): YELLOW OWNER COPY (INITIAL): PINK