IREDELL COUNTY HEALTH DEPARTMENT

STATESVILLE 704-878-5305 MOORESVILLE 704-664-5281

IMPROVEMENT PERMIT / AUTHORIZATION TO CONSTRUCT / OPERATION PERMIT / EXISTING SYSTEM INSPECTION

PERMIT# 88975 PIN# 3794 61 1170 pT DATE May 9, 2000

OWNER OR CONTRACTOR Silver Wave prop PHONE: Business 532 6527 Home

ADDRESS 551 Monroe Rd Charlotte NC

LOCATION ~~Hwy~~ Old MT Rd Nth (L) Island Ford (L) Bobby (L) Maristone 2nd STREET (R) 2nd home on Right

SUBDIVISION Featherstone BLOCK / SECTION II LOT 25 LOT AREA .71 SITE CLASS. PS DESIGN FLOW 360 L.T.A.R. .25

Septic Tank: 1000 Gallons; STB 312 Dellinger Date 4/10/00
Pump Tank: Gallons; PT Date
Pump Make: Model Serial No.
Nitrification Field: No Fields 1 Square Feet 1440 Linear Feet 360
No Lines 4 Trench Width 36" Max Trench Bottom Depth 36"+

☐ New System ☐ Repair System Type: I. II. III. IV. V. VI
System Description: Conv 25% Reduction
Repair System Description: Same
Maintenance Agreement Required: ☐ Yes ☒ No


☐ House/Mod. Home ☒ Mobile Home SW ☐ Business ☐ Other
No. Bedrooms 3 No. Bathrooms 2 No. Employees
☐ Slab ☒ Crawl Space ☐ Basement w/plumbing ☐ Basement wo/plumbing

Water Supply: ☒ Individual ☐ Public ☐ Community WELL


Comments/Conditions: Min FT CENTERS 60 Chambers OR 36 HASS Sections
LOCATE well 100FT from All Septic System OR MAX FEASIBLE
Distance (50 FT min) Well MUST be drilled
1 Foot

Comments/Conditions: Label Filter used

INITIAL SITE SKETCH

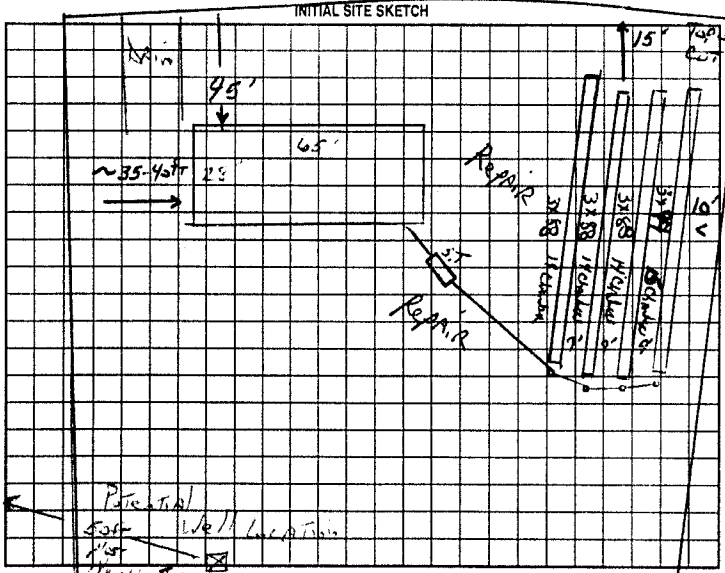

AS BUILT SKETCH

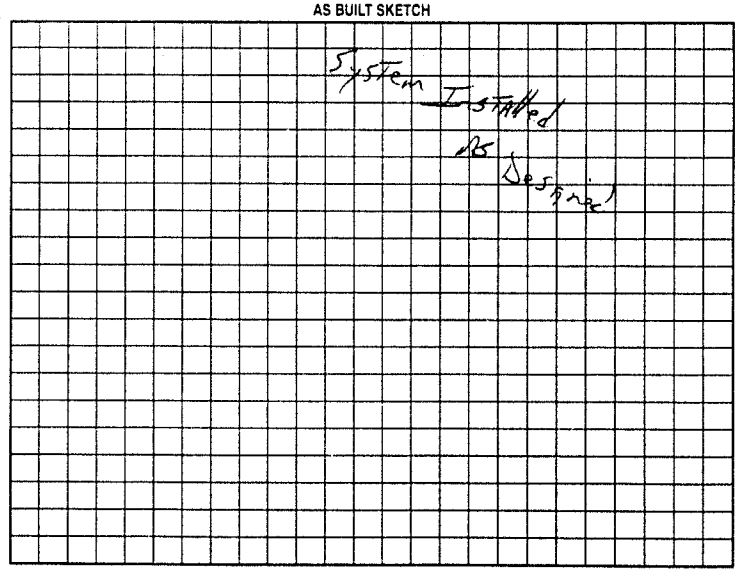

Permit can be suspended or revoked if any false information is supplied toward securing the permit/any unauthorized changes are made to the site/any unauthorized changes are made in the installation of the system. Improvement Permit with plat valid without expiration. Improvement Permit with site plan valid for sixty months. Authorization to Construct is valid for a period equal to that of Improvement Permit – not to exceed sixty months.

Signed: Steve Potter date 5/9/00 Installed by: Dellinger Grading

Improvement Permit by: C. Potter date May 9 2000 Operation Permit by: C. Potter date May 24 2000

Authorization to Construct by: C. Potter date May 9 2000 Existing System Inspection by: date

HEALTH DEPT. COPY: WHITE OWNER COPY (FINAL): YELLOW OWNER COPY (INITIAL): PINK