IREDELL COUNTY HEALTH DEPARTMENT

STATESVILLE 704-878-5305 MOORESVILLE 704-664-5281

IMPROVEMENT PERMIT / AUTHORIZATION TO CONSTRUCT / OPERATION PERMIT / EXISTING SYSTEM INSPECTION

PERMIT# 82973 PIN# 3794611170

OWNER OR CONTRACTOR Piedmont Housing PHONE: Business 528 7120 Home DATE Aug 4 99

ADDRESS 1040 Charlotte Hwy Troutman, NC

LOCATION I40 W (R) Old MR Rd (L) Island Ford (L) Caldwell Rd (L) Marston on Corner on Right by 2nd Street

SUBDIVISION Featherstone BLOCK / SECTION II LOT 26 LOT AREA .72Ac SITE CLASS B DESIGN FLOW 360 L.T.A.R. .3

Septic Tank: 1000 Gallons; STB 1012 Date 6-11-99
Pump Tank: Gallons; PT Date
Pump Make: Model Serial No.
Nitrification Field: No Fields 1 Square Feet 1200 Linear Feet 300
No Lines 4 @ 80 Trench Width 36" Max Trench Bottom Depth 36" Gravel Depth NA

☒ New System ☐ Repair System Type: I, II, III, IV, V, VI
System Description: 25% Reduction GRAVITY
Repair System Description: 25-50 Reduction
Maintenance Agreement Required: ☐ Yes ☒ No

☐ House/Mod. Home ☒ Mobile Home ☐ Business ☐ Other
No. Bedrooms 3 No. Bathrooms 2 No. Employees


☐ Slab ☒ Crawl Space ☐ Basement w/plumbing ☐ Basement wo/plumbing

Water Supply: ☒ Individual ☐ Public ☐ Community WELL


Comments/Conditions: (3) Keep System 100ft OR MAX FEASIBLE DISTANCE from WELL
(2) May use 3 flow divider Tees, DISTRIBUTION BOX w/Speed Levelers
52 CHAMBERS OR 30 HBS SECTIONS

Comments/Conditions: Note: used drop Boxes at start of lines

INITIAL SITE SKETCH

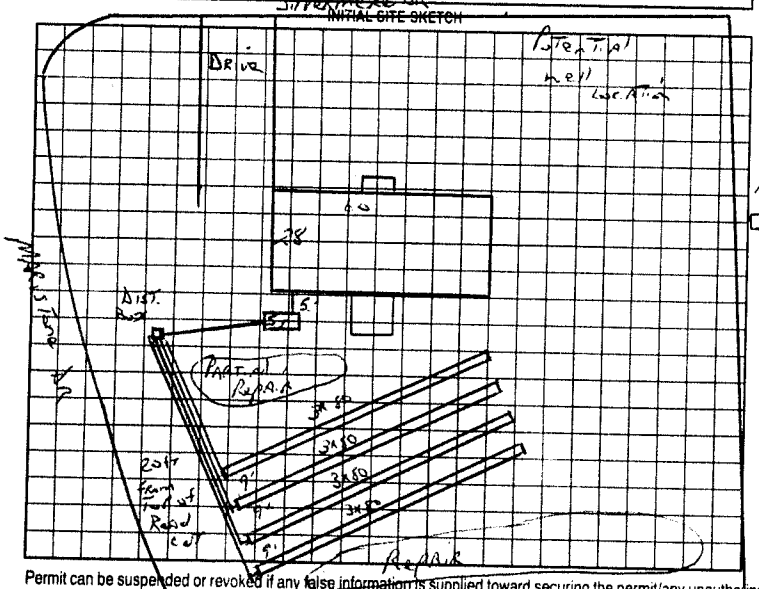

AS BUILT SKETCH

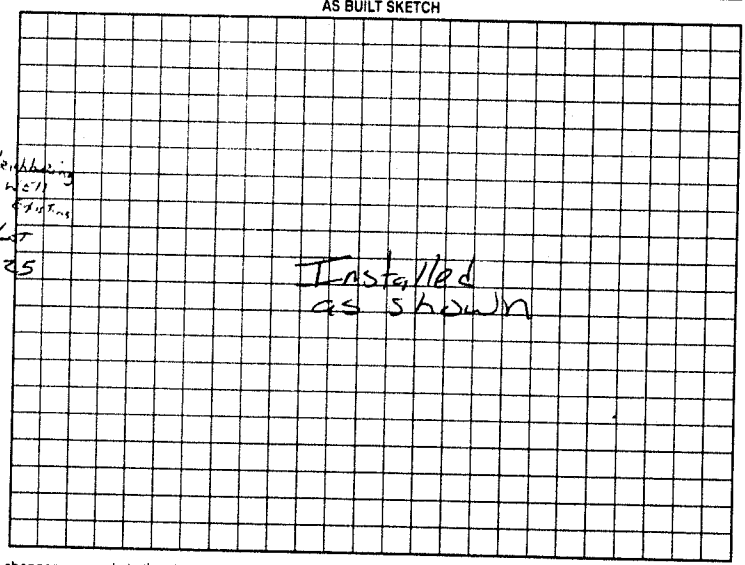

Permit can be suspended or revoked if any false information is supplied toward securing the permit/any unauthorized changes are made to the site/any unauthorized changes are made in the installation of the system. Improvement Permit with plat valid without expiration. Improvement Permit with site plan valid for sixty months. Authorization to Construct is valid for a period equal to that of Improvement Permit – not to exceed sixty months.

Signed: CR RS date 8-9-99

Improvement Permit by: JC Potter LOT 7 date 8-4-99

Authorization to Construct by: JC Potter date 8-4-99

Installed by: A-1 Backhoe

Operation Permit by: Mark Osborne date 8-12-99

Existing System Inspection by: date

HEALTH DEPT. COPY: WHITE OWNER COPY (FINAL): YELLOW OWNER COPY (INITIAL): PINK