# IREDELL COUNTY HEALTH DEPARTMENT

STATESVILLE 704-878-5305 MOORESVILLE 704-664-5281

## IMPROVEMENT PERMIT / AUTHORIZATION TO CONSTRUCT / OPERATION PERMIT / EXISTING SYSTEM INSPECTION

PERMIT# 88738 PIN# 3794611170 DATE April 25 2000

OWNER OR CONTRACTOR Clayton Homes PHONE: Business 8732547 Home

ADDRESS 2080 Neathside Dr Statesville

LOCATION Old MT Rd Nth ⓛ Island Ford ⓡ Gable ⓡ Maristone 2nd Street Right on Left Corner

SUBDIVISION Featherstone BLOCK / SECTION II LOT 16 LOT AREA 1.32 SITE CLASS. P5 DESIGN FLOW 480 L.T.A.R. .8

Septic Tank: 1000 Gallons: STB 1012 Date 3-5-00
Pump Tank: Gallons: PT Date
Pump Make: Model Serial No.
Nitrification Field: No Fields 1 Square Feet 1600 sq ft Linear Feet 400
No Lines 4 Trench Width 36" Max Trench Bottom Depth 36"

☒ New System ☐ Repair System Type: I, II, III, IV, V, VI
System Description: Gravity 25% Reduction
Repair System Description: Pump Possible 50% Reduction
Maintenance Agreement Required: ☐ Yes ☒ No
Gravel Depth N/A


☐ House/Mod. Home ☒ Mobile Home ☐ Business ☐ Other
No. Bedrooms 4 No. Bathrooms 2 No. Employees
☐ Slab ☒ Crawl Space ☐ Basement w/plumbing ☐ Basement wo/plumbing

Water Supply: ☒ Individual ☐ Public ☐ Community
WELL

Comments:/Conditions: Locate well 100ft From Septic Area
67 Chambers or 40 HDS Sections
May use Distribution Box w/ speed Levels
Not To Scale

Comments:/Conditions: SEPTIC TANK W/ MARKER INSTALLED USING "Polylok" FILTER

INITIAL SITE SKETCH

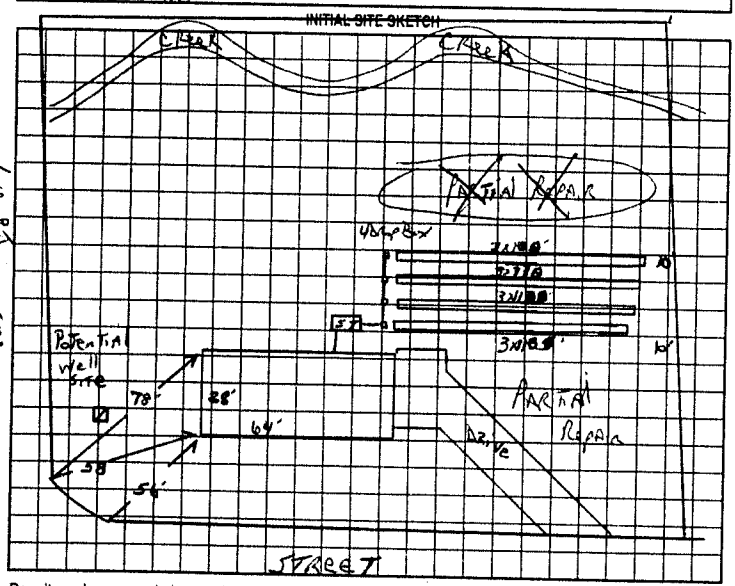


AS BUILT SKETCH

AS SHOWN

Permit can be suspended or revoked if any false information is supplied toward securing the permit/any unauthorized changes are made to the site/any unauthorized changes are made in the installation of the system. Improvement Permit with plat valid without expiration. Improvement Permit with site plan valid for sixty months. Authorization to Construct is valid for a period equal to that of Improvement Permit – not to exceed sixty months.

Signed: date 4-25-00 Installed by: A-1 BACKHOE

Improvement Permit by: J.C. Potter date April 25 2000 Operation Permit by: STEVE HEDRICK date 5-11-00

Authorization to Construct by: J.C. Potter date April 25 2000 Existing System Inspection by: date

HEALTH DEPT. COPY: WHITE OWNER COPY (FINAL): YELLOW OWNER COPY (INITIAL): PINK