This permit voids previously issues permit dated 12/19/02.

IREDELL COUNTY HEALTH DEPARTMENT

STATESVILLE 704-878-5305 MOORESVILLE 704-664-5281

IMPROVEMENT PERMIT / AUTHORIZATION TO CONSTRUCT / OPERATION PERMIT / EXISTING SYSTEM INSPECTION

PERMIT# 109972 PIN# 3794-50-7452 DATE 12/31/02

OWNER OR CONTRACTOR Fleetwood Homes of Statesville PHONE: Business (704) 872-0179 Home —

ADDRESS 1270 North Side Drive Statesville NC. 28677

LOCATION I-40 W (R) old mtn. Rd. (L) Island Ford Rd. (L) Cobb Rd. (R) Silvermere Drive on Left

SUBDIVISION Featherstone BLOCK / SECTION — / (2) LOT 17 LOT AREA 1.24 Ac SITE CLASS. #5 DESIGN FLOW 480 L.T.A.R. -30

Septic Tank: 1,000 Gallons; STB 1012 Date 6-12-02
Pump Tank: _____ Gallons; PT _____ Date _____
Pump Make: _____ Model _____ Serial No. _____
Nitrification Field: No Fields 1 Square Feet Equiv to 660 Linear Feet 400
No Lines 3 Trench Width 36" Max Trench Bottom Depth 32" Gravel Depth NA

[X] New System [ ] Repair System Type: I, II, (III), IV, V, VI
System Description: Gravity, 25% Reduction
Repair System Description: Gravity, 25% Reduction
Maintenance Agreement Required: [ ] Yes [X] No


[ ] House/Mod. Home No. Bedrooms 4
[X] Mobile Home No. Bathrooms 2
[ ] Business No. Employees ____
[ ] Other _____
[ ] Slab [X] Crawl Space [ ] Basement w/plumbing [ ] Basement wo/plumbing

Water Supply: [X] Individual [ ] Public [ ] Community

Comments/Conditions: (1) Do Not install when wet (2) Maintain Proper Setbacks (3) Keep repair 50ft from stream

Comments/Conditions: - H.D. employee approval to move S.T.
- Tuff-Tite Filter Installed, S.T marker Installed
- Infiltrator Chamber 75% - Reduction installed.
- System Installed during wet conditions

INITIAL SITE SKETCH

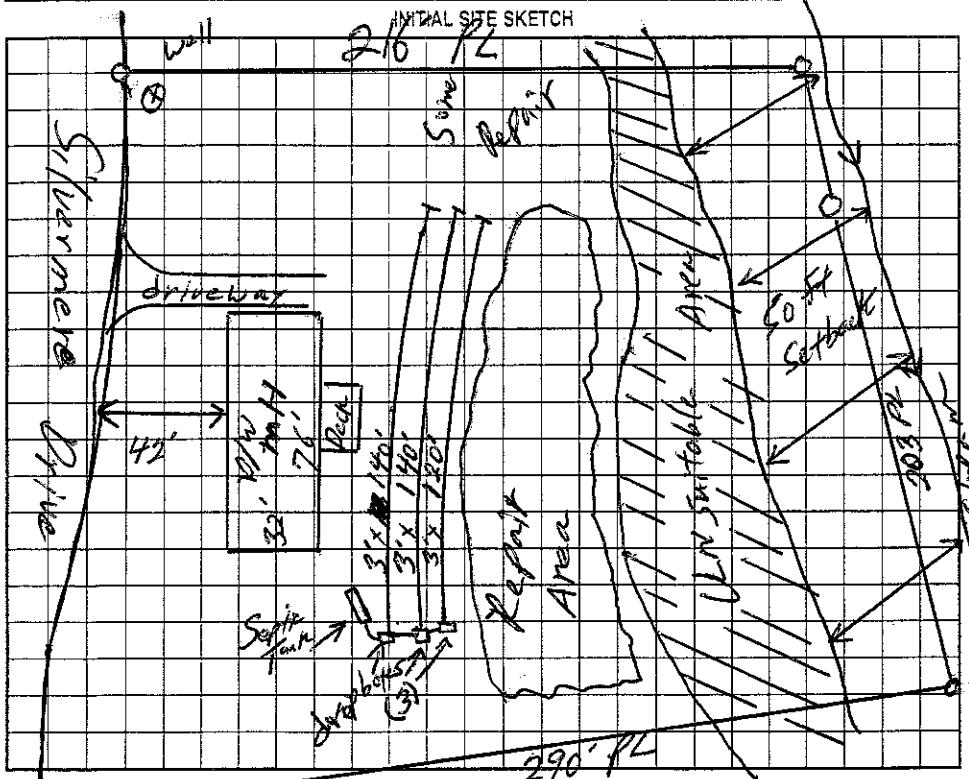

AS BUILT SKETCH

System Installed as Shown per Site Sketch

Permit can be suspended or revoked if any false information is supplied toward securing the permit/any unauthorized changes are made to the site/any unauthorized changes are made in the installation of the system. Improvement Permit with plat valid without expiration. Improvement Permit with site plan valid for sixty months. Authorization to Construct is valid for a period equal to that of Improvement Permit – not to exceed sixty months.

Signed: _____ date 2/25/03 Installed by: Craig Thompson

Improvement Permit by: William O. Johnson date 12/31/02 Operation Permit by: William O. Johnson date 2/25/03

Authorization to Construct by: William O. Johnson date 12/31/02 Existing System Inspection by: _____ date _____

HEALTH DEPT. COPY: WHITE OWNER COPY (FINAL): YELLOW OWNER COPY (INITIAL): PINK