IREDELL COUNTY HEALTH DEPARTMENT

STATESVILLE 704-878-5305 CI MOORESVILLE 704-664-5281

IMPROVEMENT PERMIT / AUTHORIZATION TO CONSTRUCT / OPERATION PERMIT / EXISTING SYSTEM INSPECTION

PERMIT# 114644 PIN# 3794-51-~~2386~~ 0983 DATE 9/4/03

OWNER OR CONTRACTOR Jane Mayhew PHONE: Business — Home (704) 872-4259

ADDRESS 114 Turtle dove Lane Statesville, N.C. 28677

LOCATION I40W, (R) Old Mtn Rd, (L) Island Ford Rd, on right past Pope Farm Road

SUBDIVISION — BLOCK / SECTION — LOT — LOT AREA ≈ 11 Acres SITE CLASS. PS DESIGN FLOW 360 L.T.A.R. .25 gpd/ft2

Septic Tank: 1000 Gallons; STB 1007 Date 5-26-04

Pump Tank: Gallons; PT Date

Pump Make: Model Serial No.

Nitrification Field: No Fields 1 Square Feet 1440 Linear Feet 480

No Lines 4 Trench Width 36" Max Trench Bottom Depth 28" Gravel Depth 12"

☒ New System ☐ Repair System Type: I, (II), III, IV, V, VI

System Description: Gravity, Conventional

Repair System Description: Gravity, Conventional

Maintenance Agreement Required: ☐ Yes ☒ No

☐ Slab ☒ Crawl Space ☐ Basement w/plumbing ☐ Basement wo/plumbing

☒ House/Mod. Home ☐ Mobile Home ☐ Business ☐ Other


No. Bedrooms 3 No. Bathrooms 4 No. Employees

Water Supply: ☒ Individual ☐ Public ☐ Community


Comments:/Conditions: (1) Install lines on contour (2) Do not install when wet (3) Keep trench bottom depth max 28" (4) Keep well 100ft from Septic System

Comments:/Conditions: - Req Polylok filter + Septic tank marker

INITIAL SITE SKETCH

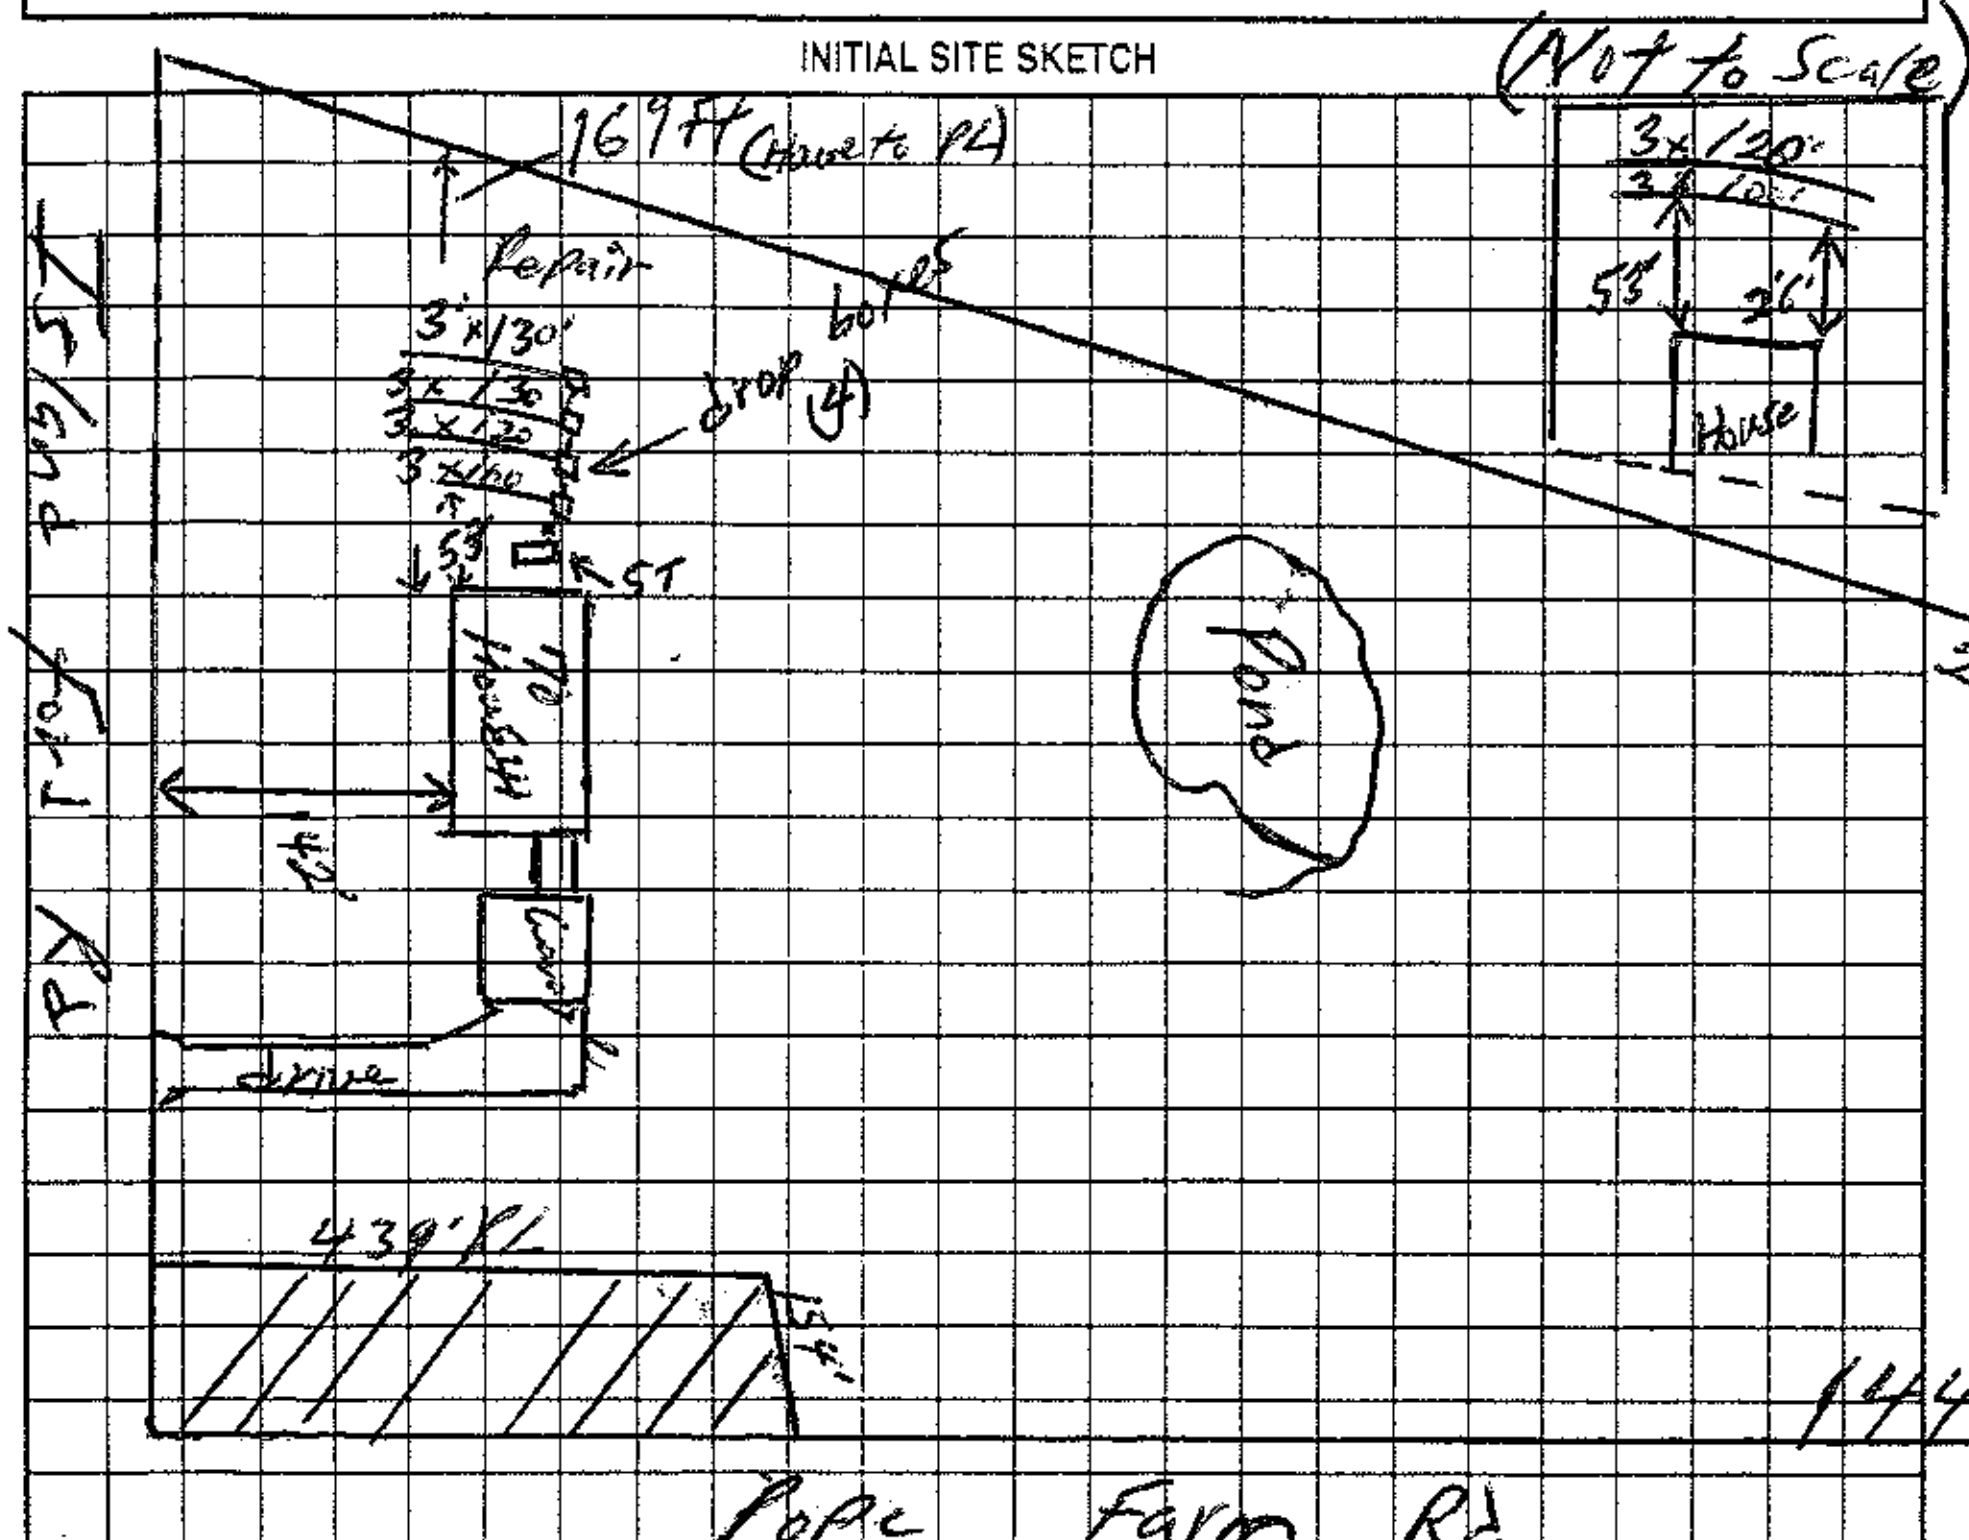

AS BUILT SKETCH

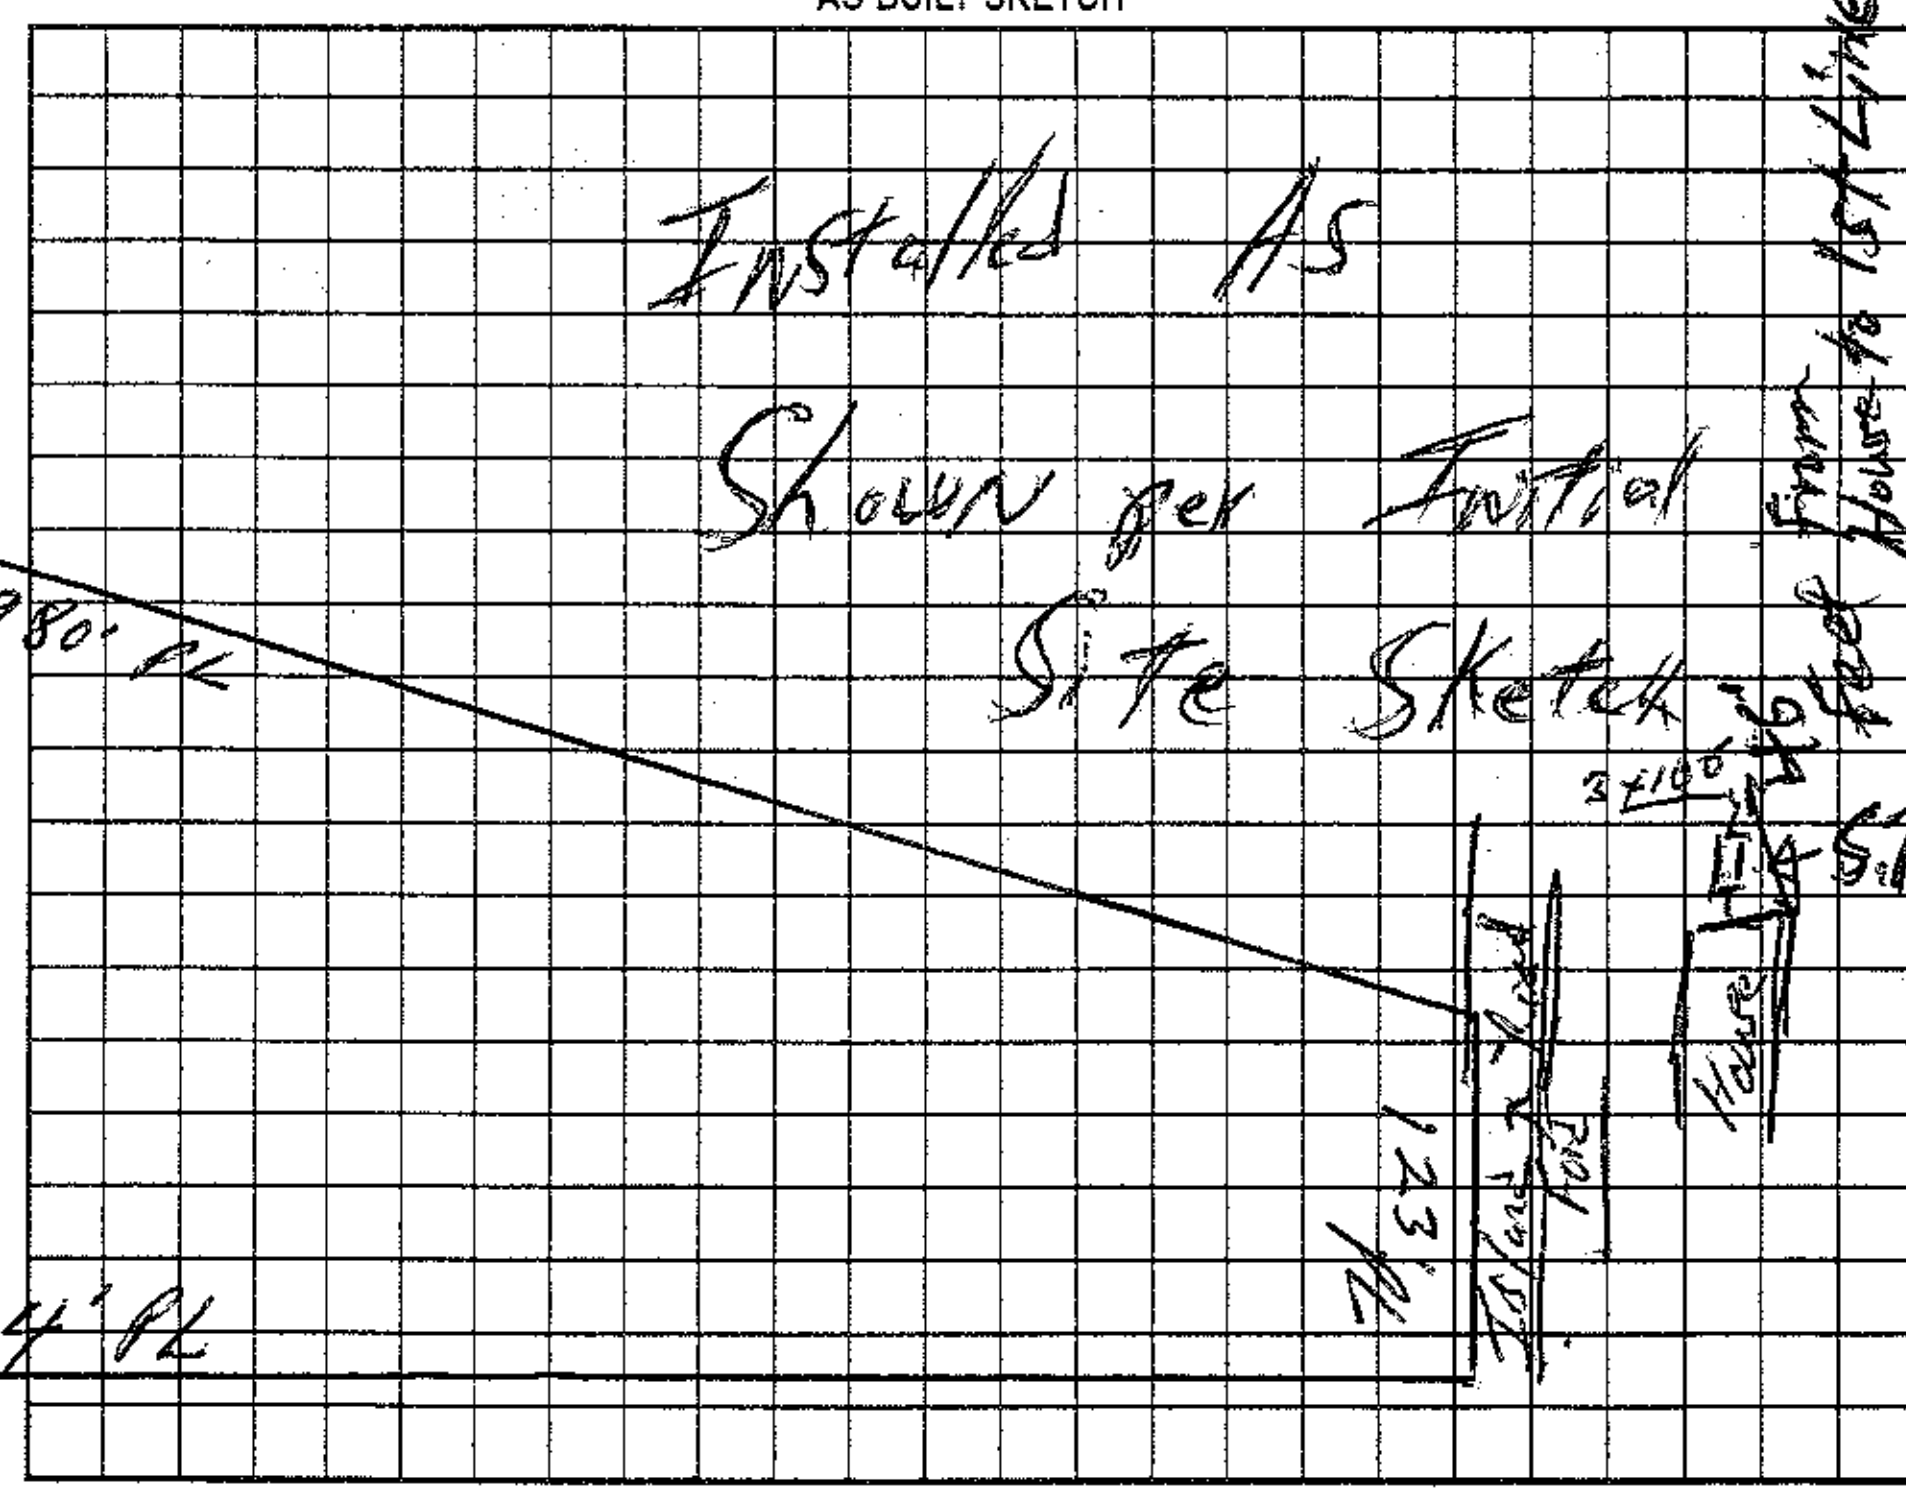

Permit can be suspended or revoked if any false information is supplied toward securing the permit/any unauthorized changes are made to the site/any unauthorized changes are made in the installation of the system. Improvement Permit with plat valid without expiration. Improvement Permit with site plan valid for sixty months. Authorization to Construct is valid for a period equal to that of Improvement Permit – not to exceed sixty months.

Signed: Jane R Mayhew date 9/4/03 Installed by: James Hudler

Improvement Permit by: William O. Johnson date 9/4/03 Operation Permit by: William O. Johnson date 7/21/04

Authorization to Construct by: William O. Johnson date 9/4/03 Existing System Inspection by: date

HEALTH DEPT. COPY: WHITE OWNER COPY (FINAL): YELLOW OWNER COPY (INITIAL): PINK