IREDELL COUNTY HEALTH DEPARTMENT

STATESVILLE 704-878-5305 MOORESVILLE 704-664-5281

IMPROVEMENT PERMIT / AUTHORIZATION TO CONSTRUCT / OPERATION PERMIT / EXISTING SYSTEM INSPECTION

PERMIT# REPAIR PIN# 3794-51-8031 DATE 2-22-05

OWNER OR CONTRACTOR AMERICAN GENERAL FINANCIAL PHONE: Business Home 704-872-3644

ADDRESS P.O. BOX 628 STATESVILLE NC 28687

LOCATION I SIANA FORD ROAD TO GOBUE ROAD, TL MARISTONE DRIVE, LOT ON LEFT ACROSS FROM KIRKLAND D

SUBDIVISION FEATHERSTONE BLOCK / SECTION II LOT 11 LOT AREA 0.69 ACRE SITE CLASS PS DESIGN FLOW 360 L.T.A.R. EXISTING 0.3

Septic Tank: EXISTING Gallons: STB Date

Pump Tank: Gallons: PT Date

Pump Make: Model Serial No.

Nitrification Field: No Fields 1 Square Feet X Linear Feet EXISTING

No Lines X Trench Width X Max Trench Bottom Depth X Gravel Depth 54" +

☐ New System ☑ Repair System Type: I, II, III, IV, V, VI

System Description: 25% REDUCTION EXISTING

Repair System Description:

Maintenance Agreement Required: ☐ Yes ☑ No

☐ House/Mod. Home No. Bedrooms 3

☑ Mobile Home No. Bathrooms

☐ Business No. Employees

☐ Other


☐ Slab ☑ Crawl Space ☐ Basement w/plumbing ☐ Basement wo/plumbing

Water Supply: ☑ Individual ☐ Public ☐ Community WELL


Comments/Conditions: ① INSTALL SUBSURFACE INTERCEPT DRAINAGE DITCH AT LOCATION SHOWN BEGINNING 60 INCHES DEEP OUT TO DAYLIGHT ② USE "TERRALIFT" TO OPEN SOIL STRUCTURE IN DRAINFIELD

Comments/Conditions: THIS LOT HAS NO REPAIR AREA AS REQUIRED BY ISA NCAC 18A .1945 (b) DUE TO UNAUTHORIZED POOL LOCATION

INITIAL SITE SKETCH

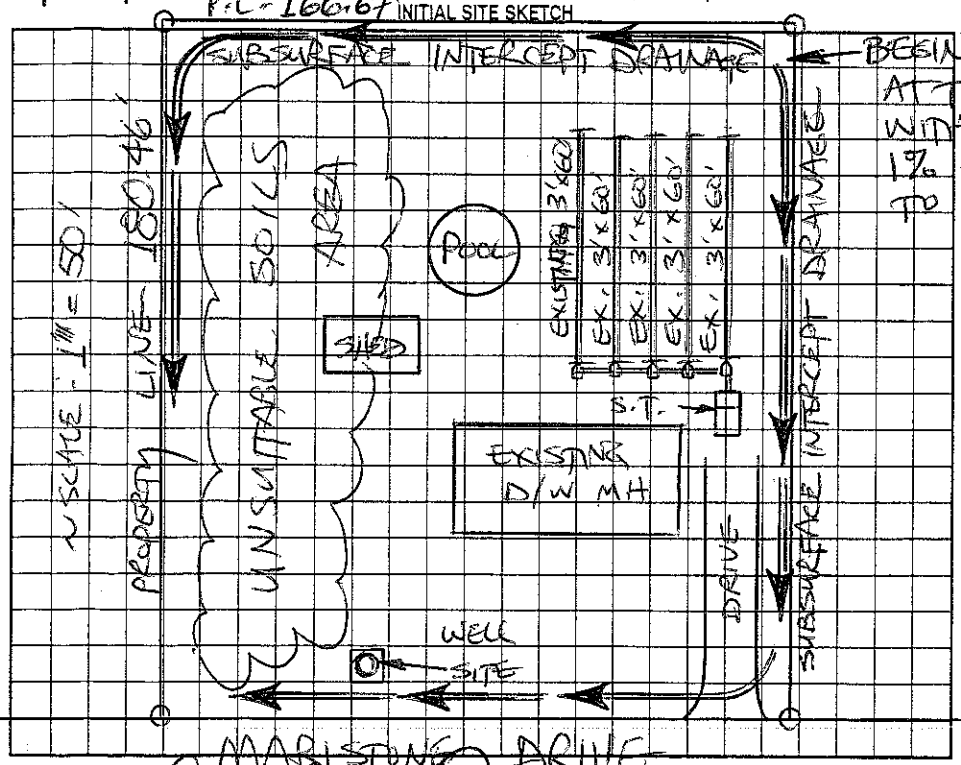

AS BUILT SKETCH

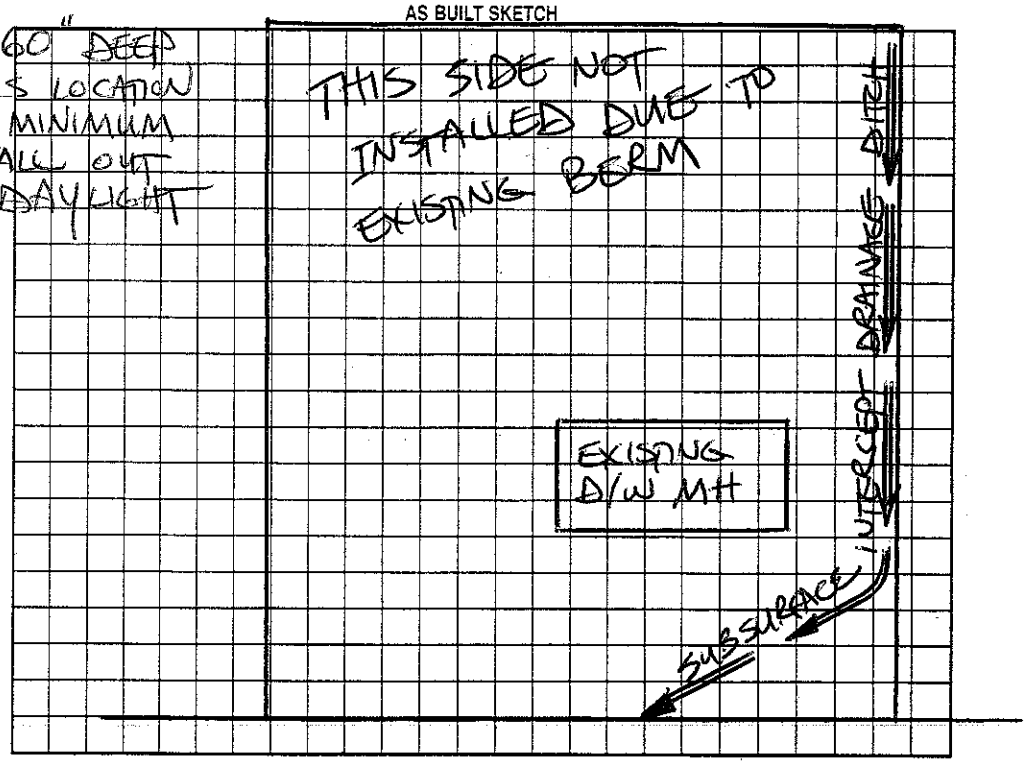

Permit can be suspended or revoked if any false information is supplied toward securing the permit/any unauthorized changes are made to the site/any unauthorized changes are made in the installation of the system. Improvement Permit with plat valid without expiration. Improvement Permit with site plan valid for sixty months. Authorization to Construct is valid for a period equal to that of Improvement Permit – not to exceed sixty months.

Signed: date 3/1/05 Installed by: JAMES HUBLER

Improvement Permit by: STEVE HEDRICK date 2-22-05 Operation Permit by: STEVE HEDRICK date 4-26-05

Authorization to Construct by: STEVE HEDRICK date 2-22-05 Existing System Inspection by: date

HEALTH DEPT. COPY: WHITE OWNER COPY (FINAL): YELLOW OWNER COPY (INITIAL): PINK