IREDELL COUNTY HEALTH DEPARTMENT

STATESVILLE 704-878-5305 MOORESVILLE 704-664-5281

IMPROVEMENT PERMIT / AUTHORIZATION TO CONSTRUCT / OPERATION PERMIT / EXISTING SYSTEM INSPECTION

PERMIT# 144544 PIN# 3794519079 DATE 8-28-07

OWNER OR APPLICANT Clinton Homes PHONE: Business 704 873 2547 Home

ADDRESS 163 Maristone Dr.

LOCATION Island Ford Rd, Left on Goble, Left on Maristone

SUBDIVISION Featherstone BLOCK / SECTION 3 LOT 34 LOT AREA .698 Ac. SITE CLASS. PS DESIGN FLOW PS L.T.A.R. .3

Septic Tank: 1000 Gallons; STB Date

Pump Tank: Gallons; PT Date

Pump Make: Model Serial No.

Nitrification Field: No Fields 1 Square Feet 1200 Linear Feet 300

No Lines Trench Width 36" Max Trench Bottom Depth 36" Gravel Depth 11

☒ New System ☐ Repair ☐ Expansion System Type: I II III IV V VI

System Description: 25% Reduction Gravity

Repair System Description: 30% Reduction (Temp ~~Gravity~~)

Maintenance Agreement Required: ☐ Yes ☒ No

☒ Gravity ☐ Pressure

☒ House/Mod. No. Bedrooms 3

☐ Mobile Home No. Persons

☐ Business No. Employees

☐ Other


Water Supply: ☒ Individual ☐ Public ☐ Community

☐ Slab ☒ Crawl Space ☐ Basement w/plumbing ☐ Basement wo/plumbing

Comments/Conditions:

(4) 3' x 75'


INITIAL SITE SKETCH

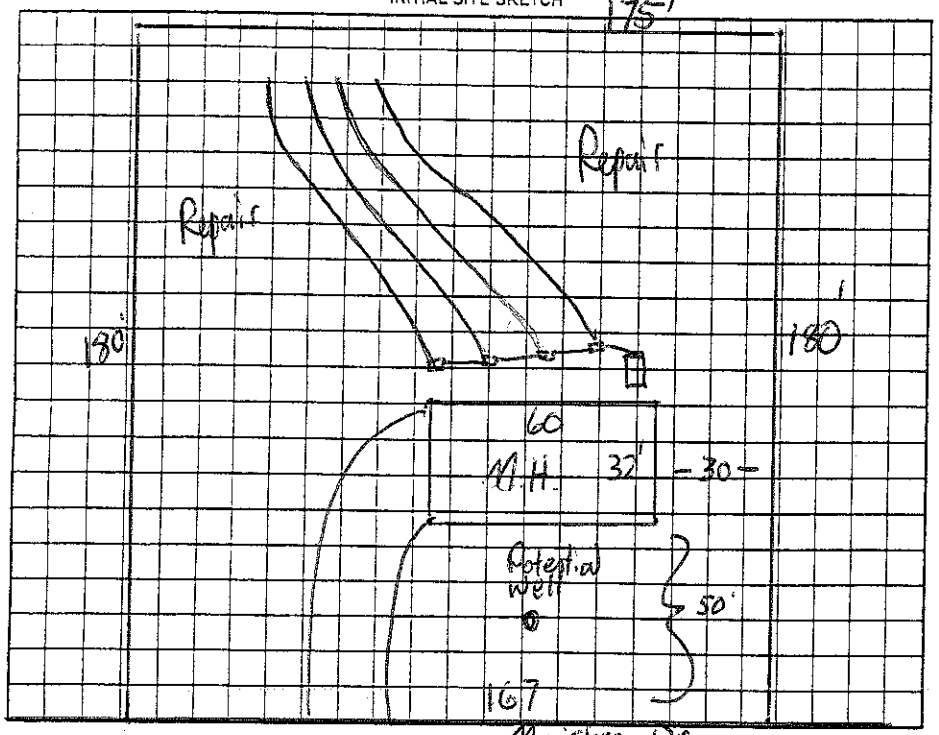

Comments/Conditions:

Septic tank
End cap distribution make
Red Poly lock

AS BUILT SKETCH

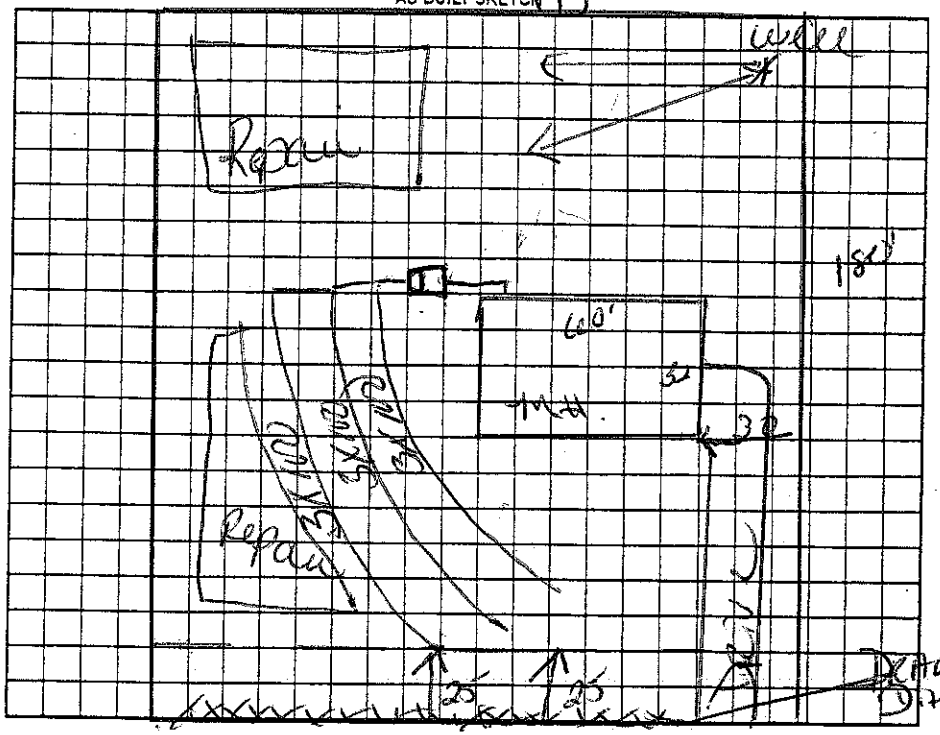

Permit can be suspended or revoked if any false information is supplied toward securing the permit/any unauthorized changes are made to the site/any unauthorized changes are made in the installation of the system. Improvement Permit with plat valid without expiration ☐ Improvement Permit with site plan valid for sixty months ☒ Authorization to Construct is valid for a period equal to that of Improvement Permit – not to exceed sixty months.

Signed: date 8-30-07

Improvement Permit by: James Stevens date 8-28-07

Authorization to Construct by: James Stevens date 8-28-07

Installed by: Abe Grading

Operation Permit by: date 8-30-07

Existing System Inspection by: date

HEALTH DEPT. COPY: WHITE OWNER COPY (FINAL): YELLOW OWNER COPY (INITIAL): PINK