IREDELL COUNTY HEALTH DEPARTMENT

STATESVILLE 704-878-5305 ✓ MOORESVILLE 704-664-5281

IMPROVEMENT PERMIT / AUTHORIZATION TO CONSTRUCT / OPERATION PERMIT / EXISTING SYSTEM INSPECTION

PERMIT# 102308 PIN# 3794-51-9593 DATE 10/4/01

OWNER OR CONTRACTOR Silver Wave Properties PHONE: Business (704) 532-6527 Home —

ADDRESS 5551 Monroe Road Charlotte NC. 28212

LOCATION Island Ford ② Cobe, ③ Maristone ④ Arboretum, 2nd on Left 4480

SUBDIVISION Featherstone BLOCK / SECTION III LOT 37 LOT AREA 1.20 Ac SITE CLASS PS DESIGN FLOW 480 L.T.A.R. .25

Septic Tank: 4,000 Gallons: STB 824 Date 9-23-01
Pump Tank: Gallons: PT Date
Pump Make: Model Serial No.
Nitrification Field: No Fields 1 Square Feet 1920 Linear Feet 640
No Lines 5 Trench Width 36" Max Trench Bottom Depth 30" Gravel Depth 12"

☒ New System ☐ Repair System Type: I (II) III. IV. V. VI
System Description: Gravity, Conventional
Repair System Description: Gravity, 25% Reduction
Maintenance Agreement Required: ☐ Yes ☒ No

☐ House/Mod. Home No. Bedrooms 4
☒ Mobile Home No. Bathrooms 2
☐ Business No. Employees
☐ Other

☐ Slab ☒ Crawl Space ☐ Basement w/plumbing ☐ Basement wo/plumbing


Water Supply: ☒ Individual ☐ Public ☐ Community

Comments/Conditions: ① Install lines on contour ② Keep septic system 100 ft from well ③ Do not install when wet


Comments/Conditions:
- Green - Zoeller Filter Installed
- Septic Tank Marker Installed

INITIAL SITE SKETCH

(Not to Scale)

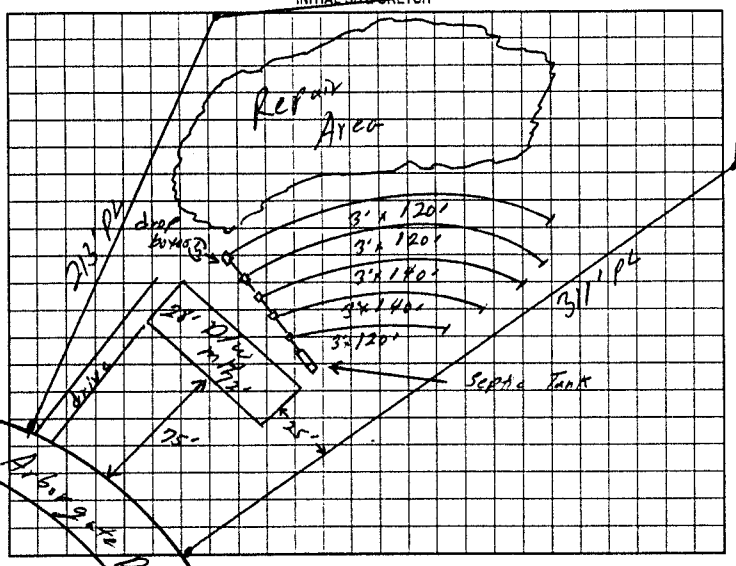

AS BUILT SKETCH

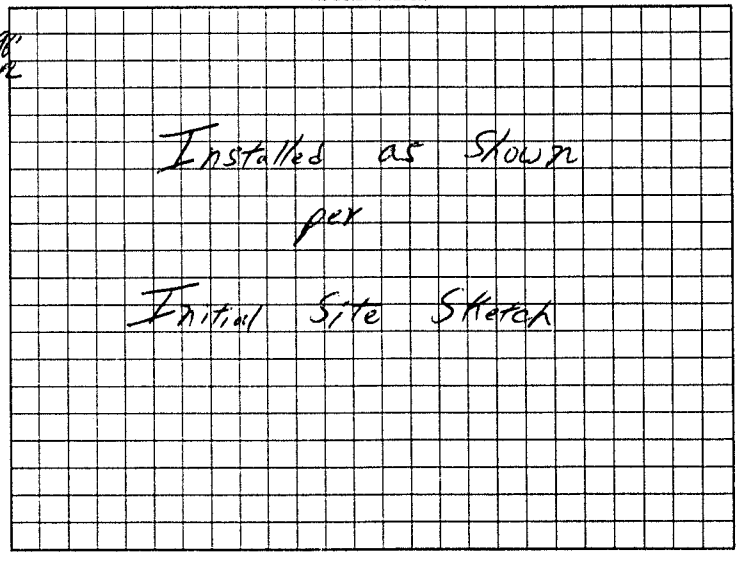

Permit can be suspended or revoked if any false information is supplied toward securing the permit/any unauthorized changes are made to the site/any unauthorized changes are made in the installation of the system. Improvement Permit with plat valid without expiration. Improvement Permit with site plan valid for sixty months. Authorization to Construct is valid for a period equal to that of Improvement Permit – not to exceed sixty months.

Signed: [signature] date 10/4/01 Installed by: Kevin Lowman

Improvement Permit by: William O. Johnson date 10/4/01 Operation Permit by: William O. Johnson date 10/31/01

Authorization to Construct by: William O. Johnson date 10/4/01 Existing System Inspection by: date

HEALTH DEPT. COPY: WHITE OWNER COPY (FINAL): YELLOW OWNER COPY (INITIAL): PINK