IREDELL COUNTY HEALTH DEPARTMENT

STATESVILLE 704-878-5305 ✓ MOORESVILLE 704-664-5281

IMPROVEMENT PERMIT / AUTHORIZATION TO CONSTRUCT / OPERATION PERMIT / EXISTING SYSTEM INSPECTION

PERMIT# 102328 PIN# 3794

OWNER OR CONTRACTOR James Houston PHONE: Business — Home (704) 873-7765 DATE 9/27/01

ADDRESS 1735 Island Ford Rd. Statesville N. C. 28625

LOCATION From Q Old Mocksville Rd. Q on Island Ford Rd ~2miles on left (inside 1735 Island Ford)

SUBDIVISION — BLOCK / SECTION — LOT — LOT AREA Acres SITE CLASS 5 DESIGN FLOW 360 L.T.A.R. .30

Septic Tank: 1000 Gallons: STB 9-11-01 Date 1007

Pump Tank: — Gallons: PT — Date —

Pump Make: — Model — Serial No —

Nitrification Field: No Fields 1 Square Feet 1200 Linear Feet 400

No Lines 40/00 Trench Width 36" Max Trench Bottom Depth 30" Gravel Depth 12"

X New System ☐ Repair System Type: I. II. III. IV. V. VI

System Description: Gravity, Conventional

Repair System Description: Gravity Conventional

Maintenance Agreement Required: ☐ Yes X No

☐ Slab X Crawl Space ☐ Basement w/plumbing ☐ Basement wo/plumbing

☐ House/Mod. Home No. Bedrooms 3

X Mobile Home No. Bathrooms 2

☐ Business No. Employees —


☐ Other —

Water Supply: X Individual ☐ Public ☐ Community

Comments/Conditions: ① Do not install when wet ② Install Septic lines on Contour ③ Keep Septic System 100± From Wells.

Comments/Conditions: - Septic Tank Risers Installed - Poly Lok Filter Installed

INITIAL SITE SKETCH

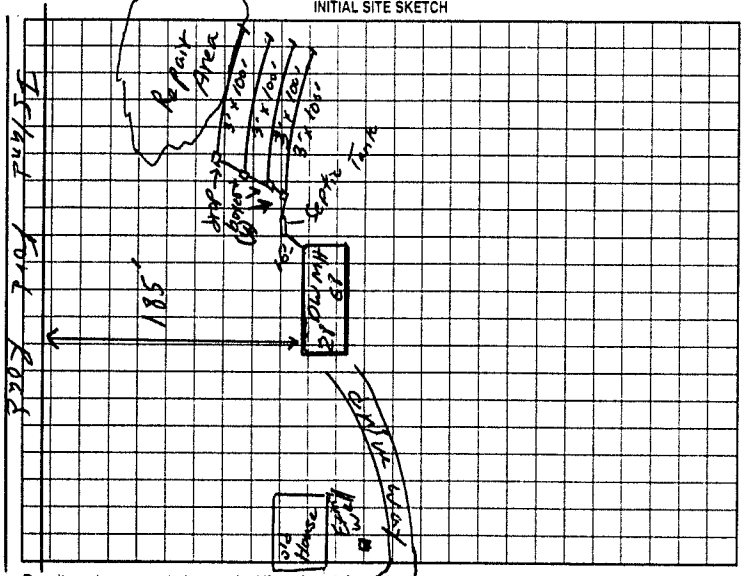

AS BUILT SKETCH

Installed as Shown

Permit can be suspended or revoked if any false information is supplied toward securing the permit/any unauthorized changes are made to the site/any unauthorized changes are made in the installation of the system. Improvement Permit with plat valid without expiration. Improvement Permit with site plan valid for sixty months. Authorization to Construct is valid for a period equal to that of Improvement Permit – not to exceed sixty months.

Signed: Nancy Houston date 9/27/01 Installed by: Wendy Scott Greene

Improvement Permit by: William O. Johnson date 9/27/01 Operation Permit by: William O. Johnson date 10/17/01

Authorization to Construct by: William O. Johnson date 9/27/01 Existing System Inspection by: — date —

HEALTH DEPT COPY WHITE OWNER COPY (FINAL) YELLOW OWNER COPY (INITIAL): PINK