IREDELL COUNTY HEALTH DEPARTMENT

STATESVILLE 704-878-5305 MOORESVILLE 704-664-5281

IMPROVEMENT PERMIT / AUTHORIZATION TO CONSTRUCT / OPERATION PERMIT / EXISTING SYSTEM INSPECTION

PERMIT# ~~82857~~ 82964 PIN# ~~4701-86-8750~~ 3794611170 DATE 5/6 29 99

OWNER OR CONTRACTOR John Allegra PHONE: Business _____ Home 922 5469

ADDRESS 116 April Ln Dallas, NC 28034

LOCATION I40 W (R) Old NT Rd (L) Island Ford (L) Cobble Rd (L) MARISTone (R) Silvermine Rd AT end

SUBDIVISION Fernhurstone BLOCK / SECTION II LOT 20 LOT AREA 1.5 Ac SITE CLASS. B DESIGN FLOW 360 L.T.A.R. .3

Septic Tank: 1000 Gallons: STB 825 Date 5.1199
Pump Tank: _____ Gallons: PT _____ Date _____
Pump Make: _____ Model _____ Serial No. _____
Nitrification Field: No Fields 1 Square Feet 1600 Linear Feet ~~600~~ 533
No Lines 5 Lines Trench Width 36" Max Trench Bottom Depth 36' Gravel Depth 12"

☒ New System ☐ Repair System Type: I. II. III. IV. V. VI
System Description: Conv. Gravity
Repair System Description: Same
Maintenance Agreement Required: ☐ Yes ☒ No

☐ House/Mod. Home ☒ Mobile Home ☐ Business ☐ Other
No. Bedrooms 4 No. Bathrooms 3 No. Employees ____
☐ Slab ☒ Crawl Space ☐ Basement w/plumbing ☐ Basement wo/plumbing


Water Supply: ☒ Individual ☐ Public ☐ Community
well

Comments/Conditions: Five Lines on Contour 5 Drop Boxes or One Dist. Box, Keep All prop. Set backs


PL 317' Total

Comments/Conditions:

INITIAL SITE SKETCH

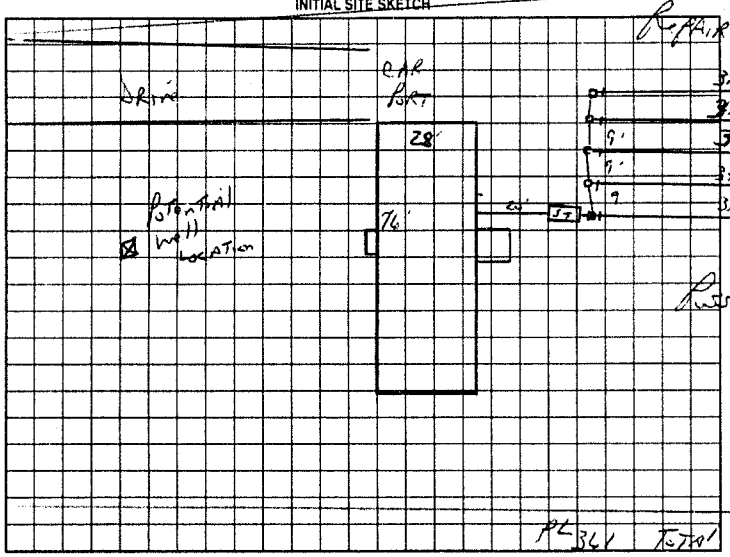

AS BUILT SKETCH

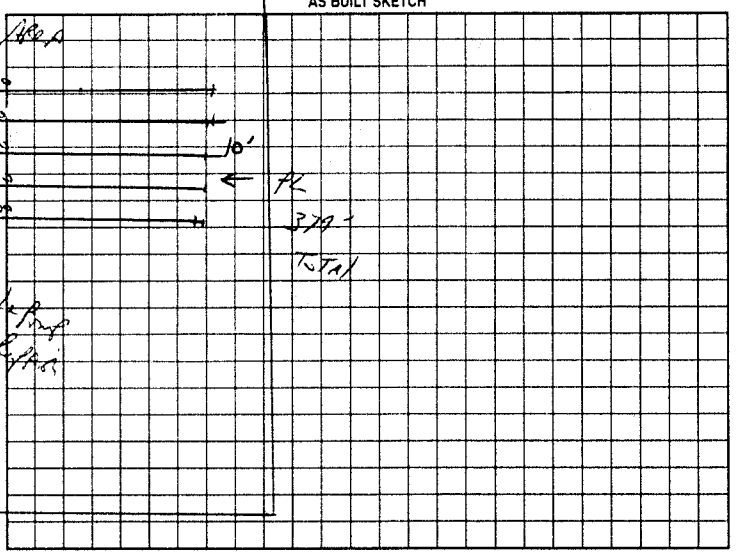

Permit can be suspended or revoked if any false information is supplied toward securing the permit/any unauthorized changes are made to the site/any unauthorized changes are made in the installation of the system. Improvement Permit with plat valid without expiration. Improvement Permit with site plan valid for sixty months. Authorization to Construct is valid for a period equal to that of Improvement Permit – not to exceed sixty months.

Signed: John Allegra date 7/29/99 Installed by: C & W Grading

Improvement Permit by: J.C. Potter date 7.29.99 Operation Permit by: J.C. Potter date Sept 20 99

Authorization to Construct by: J.C. Potter date 7.29.99 Existing System Inspection by: _____ date _____

HEALTH DEPT COPY WHITE OWNER COPY (FINAL) YELLOW OWNER COPY (INITIAL) PINK