IREDELL COUNTY HEALTH DEPARTMENT

STATESVILLE 704-878-5305 MOORESVILLE 704-664-5281

IMPROVEMENT PERMIT / AUTHORIZATION TO CONSTRUCT / OPERATION PERMIT / EXISTING SYSTEM INSPECTION

PERMIT# 82966 PIN# 3794611170 DATE July 30 99

OWNER OR CONTRACTOR Silverwave Prop. 5551 Monroe Rd PHONE: Business 532-6527 Home

ADDRESS Charlotte NC

LOCATION I-40 W ® Old Mtn Rd (L) Island Ford (L) Cobble (L) Maristone, 2nd drive R. Rt. Pipe on Left end of C.L. to Site

SUBDIVISION Featherstone BLOCK / SECTION II LOT 19 LOT AREA 1.19 Ac SITE CLASS P3 DESIGN FLOW 360 L.T.A.R. .35

Septic Tank: 1500 Gallons; STB 794 Date

Pump Tank: Gallons; PT Date

Pump Make: Model Serial No.

Nitrification Field: No Fields 1 Square Feet 1028 Linear Feet 345

No. Lines 3@115 Trench Width 36" Max Trench Bottom Depth 24" Gravel Depth 12"

☒ New System ☐ Repair System Type: ☒ I ☐ II ☐ III ☐ IV ☐ V ☐ VI

System Description: Conv Gravity

Repair System Description: Gravity 25% Red. Poss.

Maintenance Agreement Required: ☐ Yes ☒ No Possible

☐ House/Mod. Home No. Bedrooms 3

☒ Mobile Home DW No. Bathrooms 2

☐ Business No. Employees

☐ Other


☐ Slab ☒ Crawl Space ☐ Basement w/plumbing ☐ Basement wo/plumbing

Water Supply: ☒ Individual ☐ Public ☐ Community WELL


Comments/Conditions: Install on contour, *Trench Depth 24" *
Locate well in front of home 100 ft from Septic System
Locate System To insure All set backs from building + Decks And Properties

Comments/Conditions

INITIAL SITE SKETCH

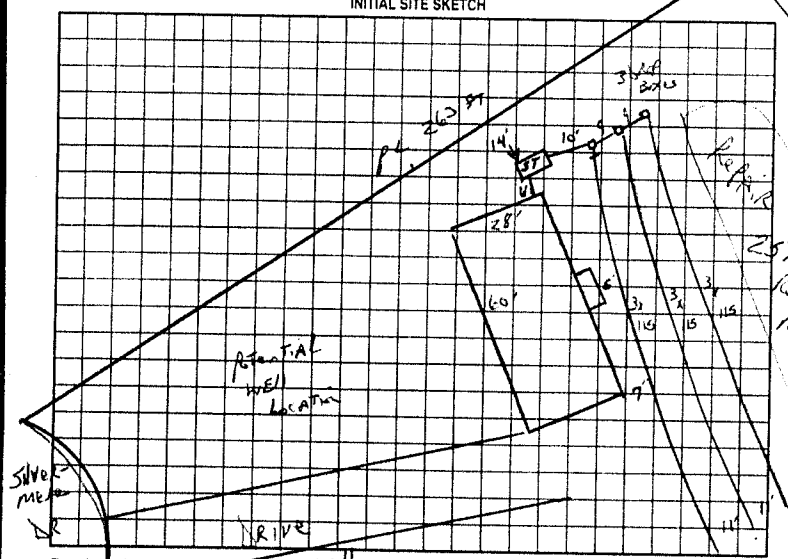

AS BUILT SKETCH

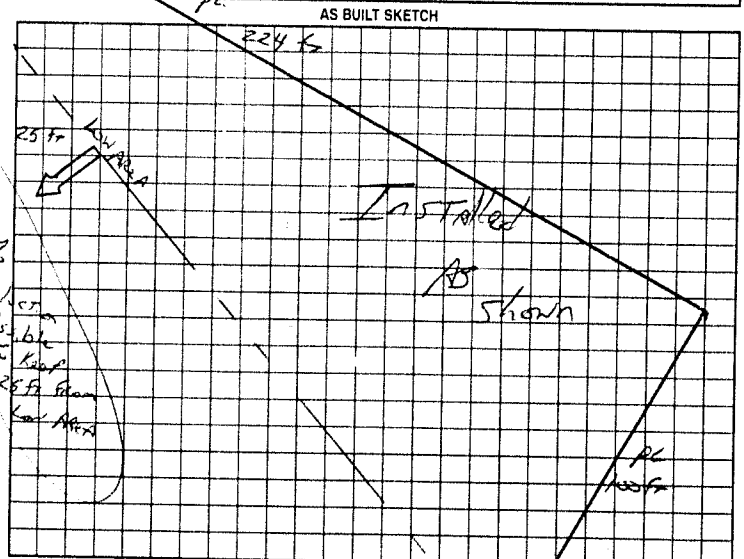

Permit can be suspended or revoked if any false information is supplied toward securing the permit/any unauthorized changes are made to the site/any unauthorized changes are made in the installation of the system. Improvement Permit with plat valid without expiration. Improvement Permit with site plan valid for sixty months. Authorization to Construct is valid for a period equal to that of Improvement Permit – not to exceed sixty months.

Signed: James J Barkley date 7-30-99

Improvement Permit by: J.C. Potter date 7-30-99

Authorization to Construct by: J.C. Potter date 7-30-99

Installed by: All Systems Inc

Operation Permit by: J.C. Potter date 9-9-99

Existing System Inspection by: date

HEALTH DEPT. COPY WHITE OWNER COPY (FINAL) YELLOW OWNER COPY (INITIAL) PINK