IREDELL COUNTY HEALTH DEPARTMENT

STATESVILLE 704-878-5305 MOORESVILLE 704-664-5281

IMPROVEMENT PERMIT / AUTHORIZATION TO CONSTRUCT / OPERATION PERMIT / EXISTING SYSTEM INSPECTION

PERMIT# 82828 PIN# 3794611170 DATE Aug 4, 99

OWNER OR CONTRACTOR Freedom Homes PHONE: Business 528 9449 Home

ADDRESS 1018 Charlotte Hwy Troutman NC

LOCATION Old Mt Rd ⓛ Elvis Foley ⓡ Cable Rd ⓛ Marstone End of Road on RT

SUBDIVISION Featherstone BLOCK / SECTION II LOT 12 LOT AREA .81 SITE CLASS. 15 DESIGN FLOW 450 L.T.A.R. .3

Septic Tank: 1000 Gallons; STB 1012 Date 7/29/99
Pump Tank: Gallons; PT Date
Pump Make: Model Serial No
Nitrification Field: No Fields 1 Square Feet 1600 Linear Feet 400
No Lines 4@102 Trench Width 36" Max Trench Bottom Depth 36" Gravel Depth N/A

☒ New System ☐ Repair System Type: I, II, III, IV, V, VI
System Description: 25% Reduction Capacity
Repair System Description: Same
Maintenance Agreement Required: ☐ Yes ☒ No

☐ House/Mod. Home ☒ Mobile Home ☐ Business ☐ Other
No. Bedrooms 4 No. Bathrooms 2 No. Employees


☐ Slab ☒ Crawl Space ☐ Basement w/plumbing ☐ Basement wo/plumbing

Water Supply: ☒ Individual ☐ Public ☐ Community WELL


Comments/Conditions: Install on contour
Maintain 100ft Setback From Well
May use 3 flow divider Tees

Comments/Conditions

INITIAL SITE SKETCH

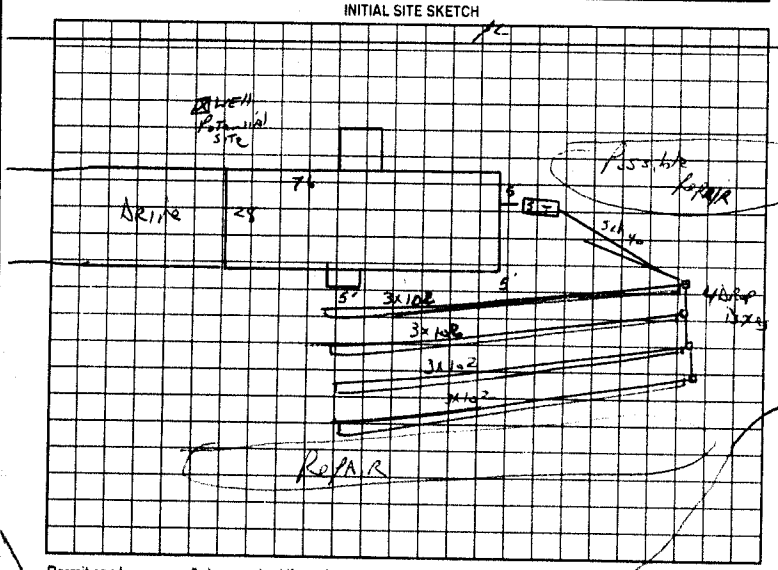

AS BUILT SKETCH

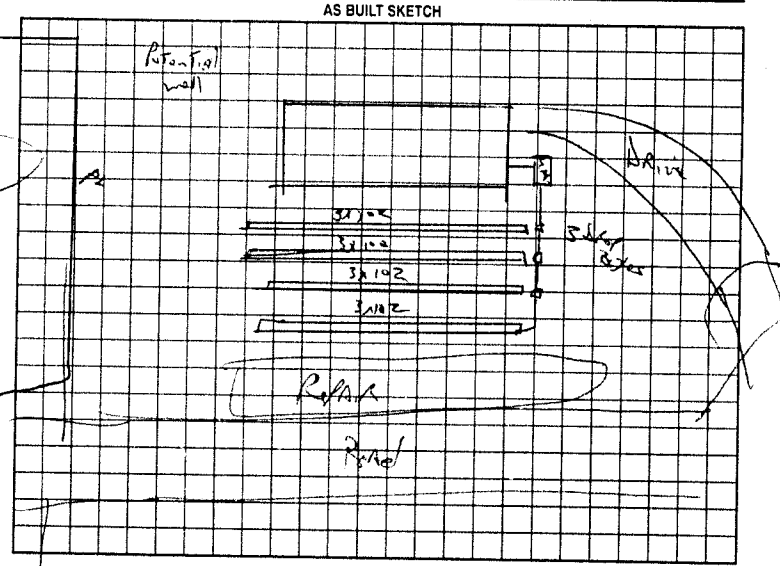

Permit can be suspended or revoked if any false information is supplied toward securing the permit/any unauthorized changes are made to the site/any unauthorized changes are made in the installation of the system. Improvement Permit with plat valid without expiration. Improvement Permit with site plan valid for sixty months. Authorization to Construct is valid for a period equal to that of Improvement Permit - not to exceed sixty months.

Signed: John Coffey date 8-4-99 Installed by: Al Brickhouse

Improvement Permit by: JC Pettis date 8.4.99 Operation Permit by: JC Pettis date Sept 21, 99

Authorization to Construct by: JC Pettis date 8499 Existing System Inspection by: date

HEALTH DEPT. COPY: WHITE OWNER COPY (FINAL): YELLOW OWNER COPY (INITIAL): PINK