IREDELL COUNTY HEALTH DEPARTMENT

STATESVILLE 704-878-5305 MOORESVILLE 704-664-5281

IMPROVEMENT PERMIT / AUTHORIZATION TO CONSTRUCT / OPERATION PERMIT / EXISTING SYSTEM INSPECTION

PERMIT# 86293 PIN# 3794611170 DATE Dec 6,99

OWNER OR CONTRACTOR Robert Halbert PHONE: Business 489-1128 Home

ADDRESS 1145 Scenic Dr Apt E Mooresville

LOCATION NB Old NMT Rd (L) Island Ford (L) Cable (L) Marstone 3rd Rd Right To end of Cul-de-sac

SUBDIVISION Featherstone BLOCK / SECTION 2 LOT 43 LOT AREA 1.12 Ac SITE CLASS RS DESIGN FLOW 480 L.T.A.R. .3

Septic Tank: 1000 Gallons; STB Date

Pump Tank: Gallons; PT Date

Pump Make: Model Serial No.

Nitrification Field: No Fields 1 Square Feet 1800 Linear Feet 300

No Lines 5 Trench Width 36" Max Trench Bottom Depth 36"

☒ New System ☐ Repair System Type: I II III IV V VI

System Description: 25% Reduction GRAVITY

Repair System Description: SAme

Maintenance Agreement Required: ☐ Yes ☒ No

Gravel Depth NA ☐ Slab ☒ Crawl Space ☐ Basement w/plumbing ☐ Basement wo/plumbing

☐ House/Mod. Home ☒ Mobile Home ☐ Business ☐ Other


No. Bedrooms 4 No. Bathrooms 2 No. Employees

Water Supply: ☒ Individual ☐ Public ☐ Community WELL


Comments/Conditions: INSTALL on CONTOUR
50 chambers OR 30 LDS sections
Keep well 100ft OR MAX FEASIBLE DISTANCE (50ft Min) from Septic System
Locate Drive & WALKS off system

Comments/Conditions 2-9-2000
66 Chambers INSTALLED

INITIAL SITE SKETCH

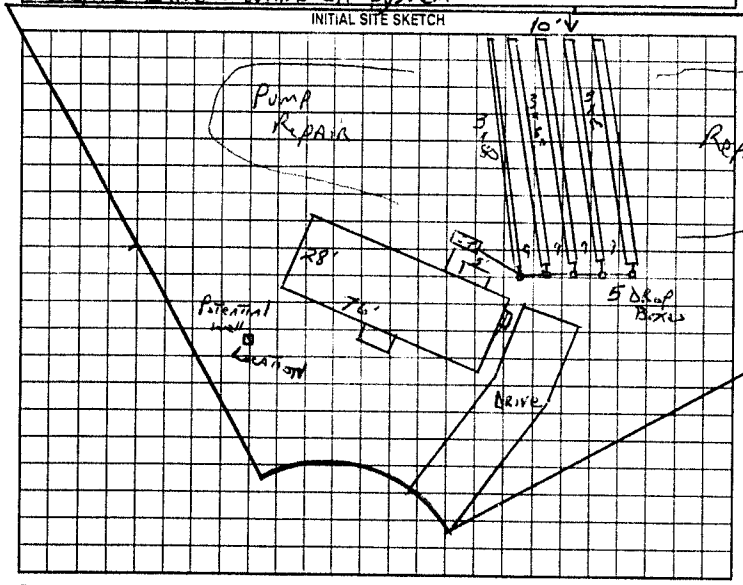

AS BUILT SKETCH

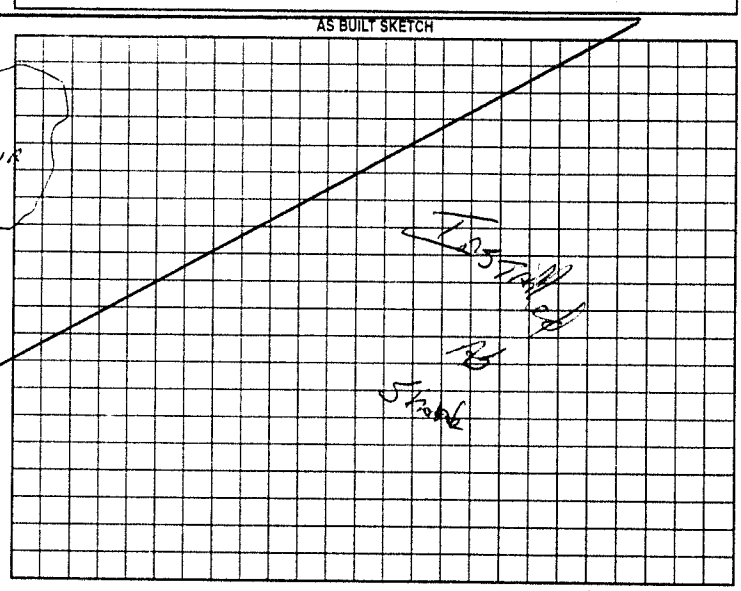

Permit can be suspended or revoked if any false information is supplied toward securing the permit/any unauthorized changes are made to the site/any unauthorized changes are made in the installation of the system. Improvement Permit with plat valid without expiration. Improvement Permit with site plan valid for sixty months. Authorization to Construct is valid for a period equal to that of Improvement Permit – not to exceed sixty months.

Signed: Tom M Reynolds date 1/25/00 Installed by: Craig Thompson

Improvement Permit by: C. Potter date Dec 6 99 Operation Permit by: C. Potter date 2-9-00

Authorization to Construct by: C. Potter date Dec 6 99 Existing System Inspection by: date

HEALTH DEPT COPY WHITE OWNER COPY (FINAL) YELLOW OWNER COPY (INITIAL) PINK