This permit voids previously issued Permit dated 5/25/02 CI

IREDELL COUNTY HEALTH DEPARTMENT

STATESVILLE 704-878-5305 MOORESVILLE 704-664-5281

IMPROVEMENT PERMIT / AUTHORIZATION TO CONSTRUCT / OPERATION PERMIT / EXISTING SYSTEM INSPECTION

PERMIT# 105124 PIN# 3794-61-3247 DATE 3/27/03

OWNER OR CONTRACTOR Fleetwood Homes PHONE: Business (704) 872-0179 Home —

ADDRESS 1270 N. Side Drive Statesville, N.C. 28625

LOCATION I-40 W @ Old Mtn Rd, @ Island Ford Rd @ Cobb @ Moorstone, Lot on left @ Mahogany

SUBDIVISION Featherstone BLOCK / SECTION III LOT 65 LOT AREA 0.86 Acres SITE CLASS. #5 DESIGN FLOW 480 L.T.A.R. .30 gpd/ft²

Septic Tank: 4000 Gallons; STB 1012 Date 8-10-02
Pump Tank: — Gallons; PT — Date —
Pump Make: — Model — Serial No. —
Nitrification Field: No Fields 1 Square Feet Eq to 1606 Linear Feet 400
No Lines 4 Trench Width 36" Max Trench Bottom Depth 36" Gravel Depth NA

☒ New System ☐ Repair System Type: I, II, III, IV, V, VI
System Description: Graute 25% Reduction
Repair System Description: ~~Pump~~ LPP
Maintenance Agreement Required: ☐ Yes ☒ No

☐ House/Mod. Home ☒ Mobile Home ☐ Business ☐ Other
No. Bedrooms 4 No. Bathrooms 2 No. Employees —


☐ Slab ☒ Crawl Space ☐ Basement w/plumbing ☐ Basement wo/plumbing

Water Supply: ☒ Individual ☐ Public ☐ Community


Comments/Conditions: ① Keep well 100ft From System ② Install Lines on Contour ③ maintain proper Setbacks.

Comments/Conditions:
- Installed 400 ft of EZ Lay
- Tuff-Tite Filter Installed, S.T. Marker Installed

INITIAL SITE SKETCH

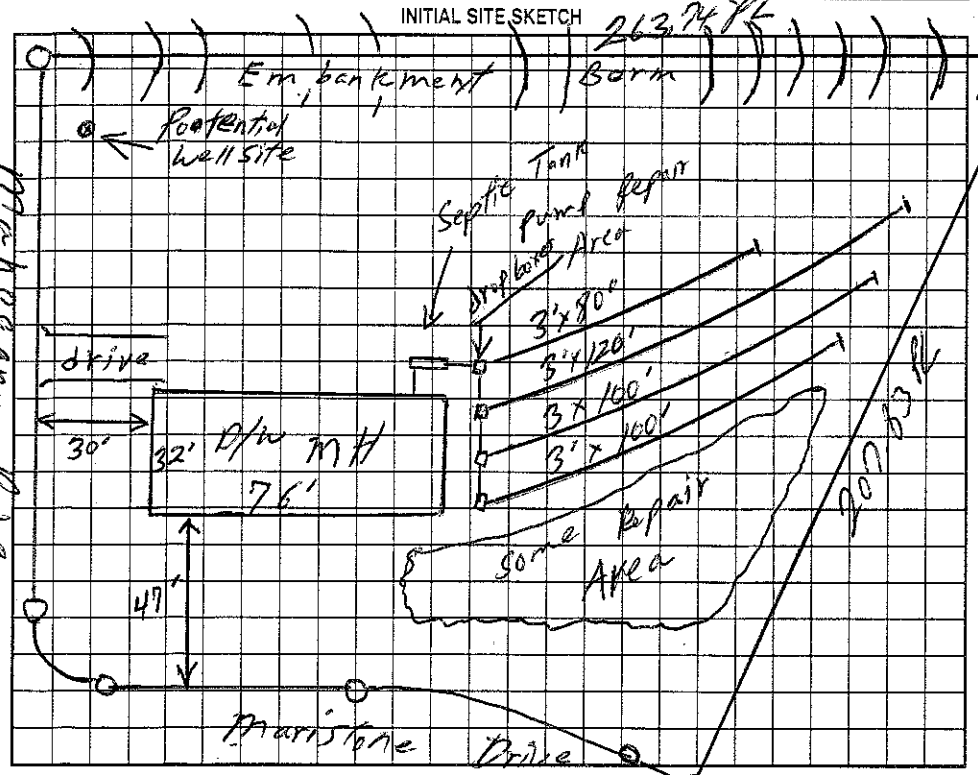

AS BUILT SKETCH (well not Installed at time of Inspection)

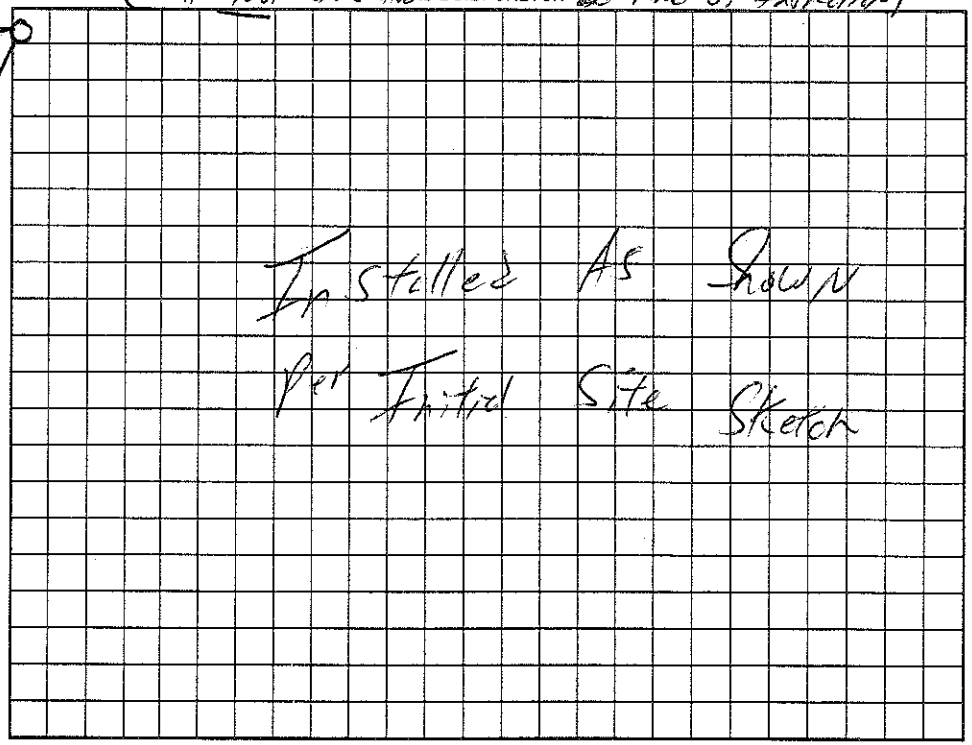

Permit can be suspended or revoked if any false information is supplied toward securing the permit/any unauthorized changes are made to the site/any unauthorized changes are made in the installation of the system. Improvement Permit with plat valid without expiration, Improvement Permit with site plan valid for sixty months. Authorization to Construct is valid for a period equal to that of Improvement Permit – not to exceed sixty months.

Signed: — date 8-27-03 Installed by: C. Thompson

Improvement Permit by: William O. Johnson date 3/27/03 Operation Permit by: William O. Johnson date 3/31/03

Authorization to Construct by: William O. Johnson date 3/27/03 Existing System Inspection by: — date —

HEALTH DEPT. COPY: WHITE OWNER COPY (FINAL): YELLOW OWNER COPY (INITIAL): PINK