IREDELL COUNTY HEALTH DEPARTMENT - *ENVIRONMENTAL HEALTH* ☑ STATESVILLE OFFICE 704-878-5305 (CV) ☐ MOORESVILLE OFFICE 704-664-5281

IMPROVEMENT PERMIT / AUTHORIZATION TO CONSTRUCT / OPERATION PERMIT / EXISTING SYSTEM INSPECTION

PERMIT # 166236 PIN # 3794-61-4408 DATE MAY 24 2011

OWNER FIRST CHOICE HOME APPLICANT: SAME PHONE: Home/Cell # 704-902-7308 Business # 704-883-8228

SITE ADDRESS 128 ARBORGATE LOOP OWNER / APPLICANT ADDRESS 119 BEECHNUT LANE STATESVILLE, NC

SITE DIRECTIONS ISLAND FORD RD, TO GOBLE ROAD, TL MARISTONE, TL ARBORGATE, 3RD LOT ON RIGHT

SUBDIVISION FEATHERSTONE BLOCK / SECTION LOT # 67 LOT AREA 0.69 ACRE DESIGN FLOW 480 L.T.A.R. 0.30 GPD/SQFT

Septic Tank 1000 Gallons: STB Date
Pump Tank Gallons: P T Date
Pump Make Model Serial #
No. Nitrification Fields: 1 No. Lines 6 Linear Feet 270
Trench Width 24" Max. Trench Bottom Depth 36" Gravel Depth 24"


☑ New System ☐ Repair ☐ Expansion System Type I II (III) IV V VI
System Description: 50% REDUCTION PPBPS
Repair System Description: 50% REDUCTION, LOW-PRESS
Maintenance Agreement Required ☐ YES ☒ NO
☑ GRAVITY ☐ PRESSURE

☑ Residence No. Bedrooms 4
☐ Business No. Persons
☐ Other No. Employees
☐ Slab ☑ Crawl Space
☐ Basement w/plumbing ☐ Basement w/o plumbing

Water Supply: ☑ Private WELL ☐ Public ☐ Community

Comments / Conditions: ① INSTALL 50% REDUCTION SYSTEM ON CONTOUR AS SHOWN USING 60 PPBPS PANELS IN SIX EQUAL LENGTH LINES, ② SCOUR TRENCH SIDEWALLS & APPLY LIME PRIOR TO INSTALLING SAND & PANELS ③ USE ONE FLOW DIVIDER TEE TO FEED TWO EFFLUENT SPLITTERS TO ACHIEVE EQUAL DISTRIBUTION INTO EACH DRAINLINE AS SHOWN.

INITIAL SITE SKETCH

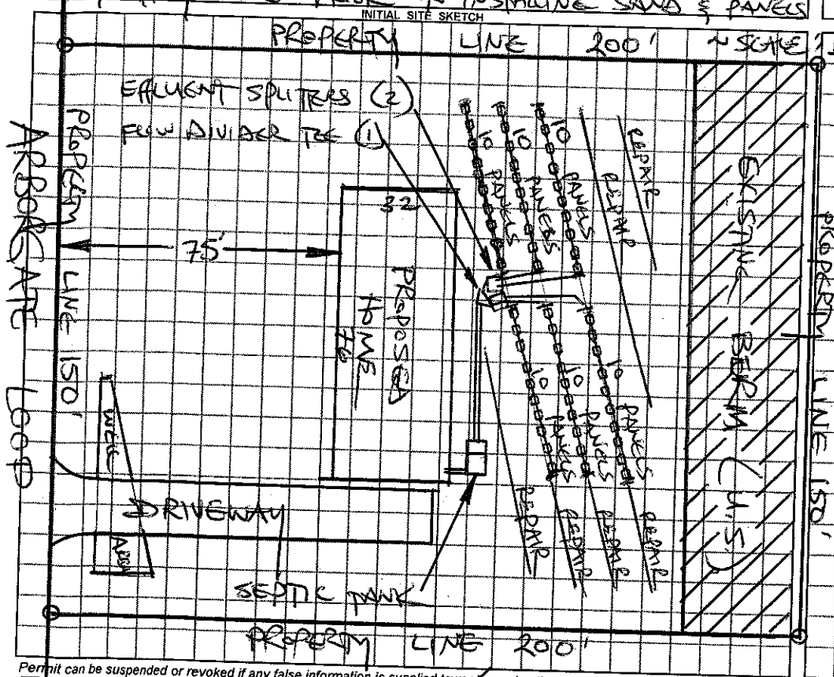

AS BUILT SKETCH

SYSTEM INSTALLED ACCORDING TO INITIAL SITE SKETCH

Permit can be suspended or revoked if any false information is supplied toward securing the permit / any unauthorized changes are made to the site / any unauthorized changes are made in the installation of the system.

☐ ***IMPROVEMENT PERMIT*** *with plat valid without expiration.* ☑ ***IMPROVEMENT PERMIT*** *with plat ~~valid without expiration~~ site plan valid 60 mo.* ☐ ***AUTHORIZATION TO CONSTRUCT*** valid for period equal to IMPROVEMENT PERMIT--not to exceed 60 mo.

Owner / Applicant Signature: [signature] Date 5-26-11

IMPROVEMENT PERMIT by: STEVE HEDRICK REHS Date 5-24-11

AUTHORIZATION TO CONSTRUCT by: STEVE HEDRICK REHS Date 5-24-11

YOU SHOULD CONTACT A LOCATOR SERVICE PRIOR TO ANY EXCAVATION

Installed by: JEREMY HILDRETH SEPTIC TANK (ANSON CO.)

OPERATION PERMIT by: R. STEVE HEDRICK REHS Date 6-23-11

Existing System Inspected by: REHS Date

White Copy – Environmental Health YELLOW COPY (Final) Owner / Applicant PINK COPY (Initial) Owner / Applicant