IREDELL COUNTY HEALTH DEPARTMENT

STATESVILLE 704-878-5305 @ MOORESVILLE 704-664-5281

IMPROVEMENT PERMIT / AUTHORIZATION TO CONSTRUCT / OPERATION PERMIT / EXISTING SYSTEM INSPECTION

PERMIT# 120007 PIN# 3794-61-7090 DATE 20 May 08

OWNER OR APPLICANT Clayton Homes of Statesville PHONE: Business 704-873-2547 Home

ADDRESS 2026 Northside Drive Statesville, NC

LOCATION Island Ford Rd Turn onto Cable TL Mainstone Lot on Rt.

SUBDIVISION Featherstone BLOCK / SECTION LOT 60 LOT AREA 0.905 Ac. SITE CLASS PS DESIGN FLOW 480 gpd L.T.A.R. 0.32/0.42

Septic Tank: 1000 Gallons: STB 700 Date 12-7-07

Pump Tank: Gallons: PT Date

Pump Make: Model Date Serial No.

Nitrification Field: No Fields 1 Square Feet 1600 Linear Feet 400

No Lines 4 Trench Width 36" Max Trench Bottom Depth 36" Gravel Depth

☑ New System ☐ Repair ☐ Expansion System Type: I II III IV V VI

System Description: 25% Reduction

Repair System Description: 25% Reduction

Maintenance Agreement Required: ☐ Yes ☑ No

☑ Gravity ☐ Pressure ☐ Slab ☐ Crawl Space ☐ Basement w/plumbing ☐ Basement wo/plumbing

☑ House/Mod. Home No. Bedrooms 4

☐ Mobile Home No. Persons

☐ Business No. Employees

☐ Other

Water Supply: ☑ Individual ☐ Public ☐ Community

Comments:/Conditions: Follow contour

Comments:/Conditions:

INITIAL SITE SKETCH

Please see attached layout plan

AS BUILT SKETCH

No Stamp

DS

Drawing

ermit can be suspended or revoked if any false information is supplied toward securing the permit/any unauthorized changes are made to the site/any unauthorized changes are made in the installation of the system. Improvement rmit with plat valid without expiration ☐ Improvement Permit with site plan valid for sixty months ☑ Authorization to Construct is valid for a period equal to that of Improvement Permit – not to exceed sixty months.

ned: Installed by:

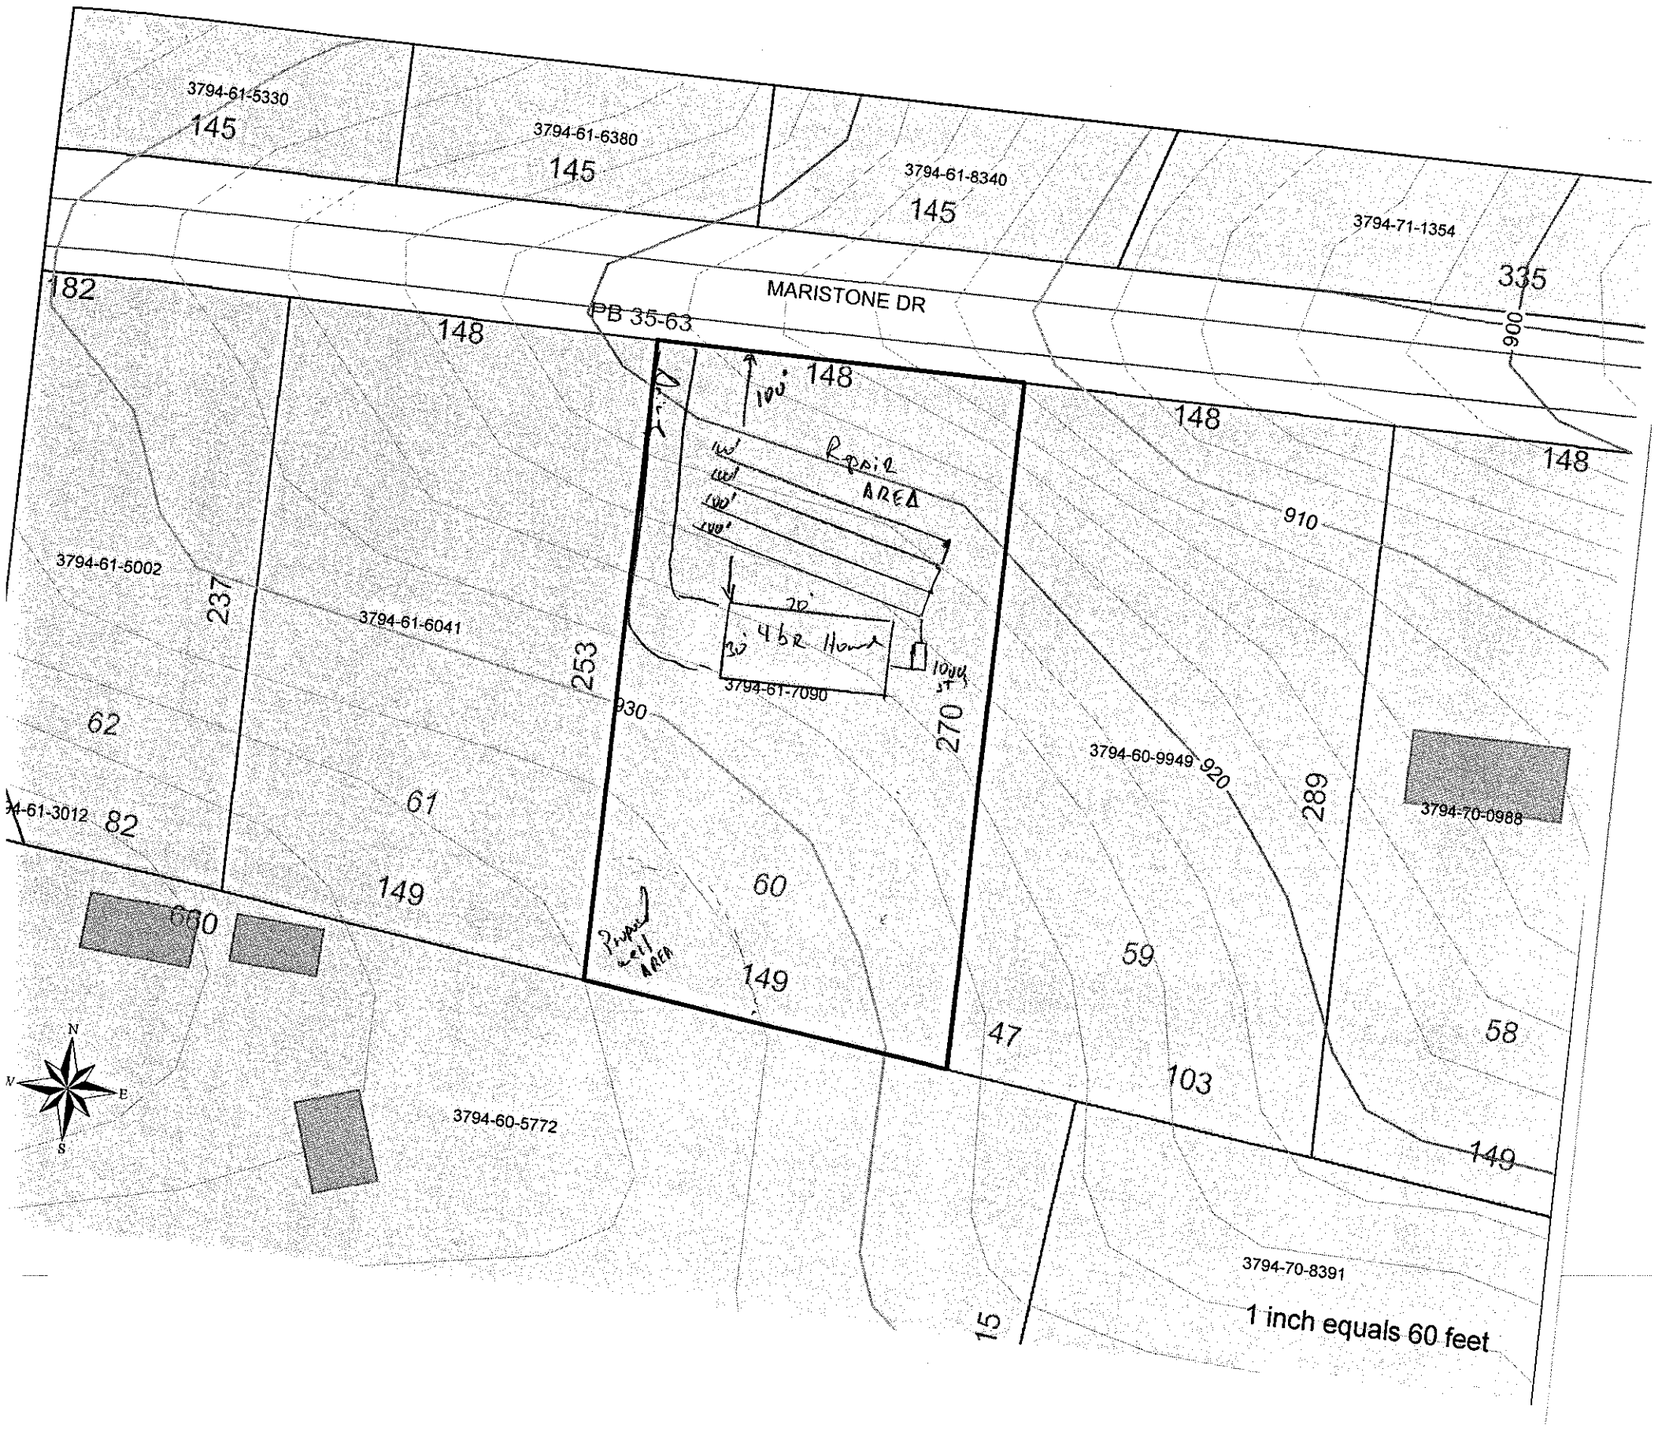
ovement Permit by: R.S. date 5/21/08

orization to Construct by: R.S. date 20 May 08 Operation Permit by: R.S. date 20 May 08

Existing System Inspection by: date 5 June 08

date

HEALTH DEPT. COPY: WHITE OWNER COPY (FINAL): YELLOW OWNER COPY (INITIAL): PINK


3794-61-5330
145
3794-61-6380
145
3794-61-8340
145
3794-71-1354
MARISTONE DR
PB 35-63
182
148
148
148
148
335
900
100'
Repair AREA
910
3794-61-5002
237
3794-61-6041
253
930
3794-61-7090
270
3794-60-9949
920
289
3794-70-0988
62
61
60
59
58
82
149
660
Proposed Set AREA
47
103
149
3794-60-5772
3794-70-8391
15
1 inch equals 60 feet
N
W
E
S