IREDELL COUNTY HEALTH DEPARTMENT

STATESVILLE 704-878-5305 MOORESVILLE 704-664-5281

IMPROVEMENT PERMIT / AUTHORIZATION TO CONSTRUCT / OPERATION PERMIT / EXISTING SYSTEM INSPECTION

PERMIT# 090064 PIN# 3794 61 1170 (PART) DATE 7-15-2000

OWNER OR CONTRACTOR PIEDMONT HOUSING PHONE: Business 872-0179 Home

ADDRESS 1270 NORTHSIDE DRIVE, STATESVILLE, NC 28677

LOCATION ISLAND FORD ROAD, TL GOBLE ROAD, TL MARISTONE DR, LOT ON LEFT AT MAHOSANY

SUBDIVISION FEATHERSTONE BLOCK / SECTION III LOT 49 LOT AREA 0.70 ACRE SITE CLASS PS DESIGN FLOW 480 L.T.A.R. 0.30 GPD/FT²

Septic Tank: 1000 Gallons; STB 1012 Date 4-4-2000
Pump Tank: 1000 Gallons; PJ 17 Date
Pump Make: HydroMatic Model SK50A1 Serial No
Nitrification Field: No Fields 1 Square Feet 480 to 1600 Linear Feet 270
No Lines FIVE Trench Width 24" Max Trench Bottom Depth 28"

☑ New System ☐ Repair System Type: I. II. III. IV. V
System Description LOW PRESSURE PIPE PPBPS
Repair System Description: LOW PRESSURE PIPE PPBPS
Maintenance Agreement Required: ☑ Yes ☐ No
~~Gravel~~ Depth SAND 6" ☐ Slab ☑ Crawl Space ☐ Basement w/plumbing ☐ Basement wo/plumbing


☐ House/Mod. Home No. Bedrooms 4
☑ Mobile Home No. Bathrooms 2
☐ Business No. Employees
☐ Other

Water Supply: ☑ Individual ☐ Public ☐ Community


Comments/Conditions: ① KEEP SYSTEM MAXIMUM FEASIBLE DISTANCE (60') FROM WELL ② INSTALL SUBSURFACE INTERCEPT DRAINAGE DITCH BEGINNING 42" DEEP OUT TO DAYLIGHT ③ INSTALL SIXTY (60) PPBPS PANELS ON CONTOUR AS SHOWN

Comments/Conditions: ④ A CONTRACT SHALL BE EXECUTED BETWEEN THE SYSTEM OWNER AND A MANAGEMENT ENTITY PRIOR TO ISSUANCE OF OPERATION PERMIT (.1961(e))

INITIAL SITE SKETCH

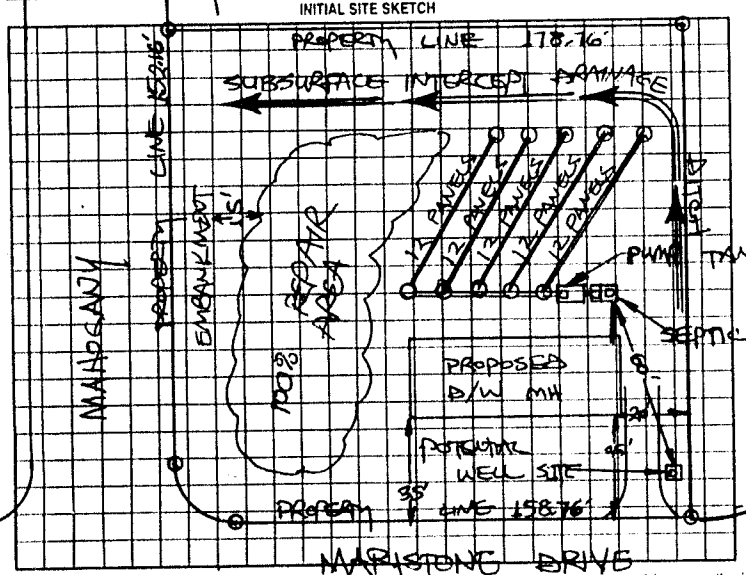

AS BUILT SKETCH

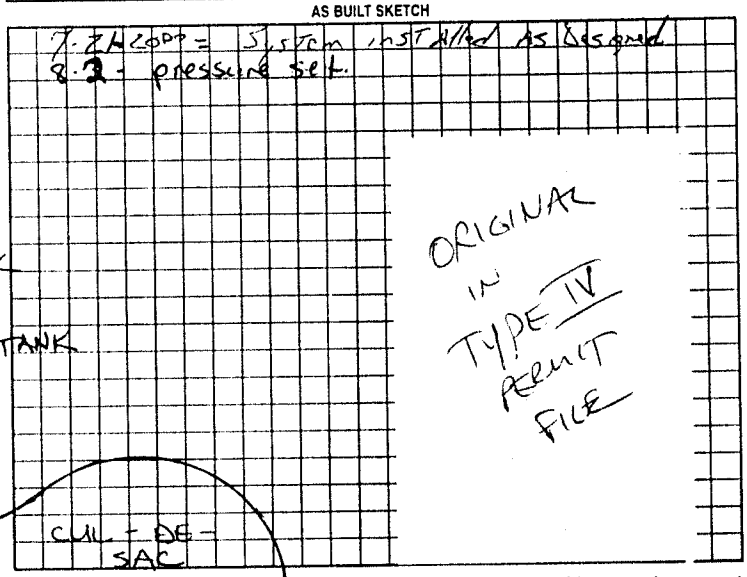

Permit can be suspended or revoked if any false information is supplied toward securing the permit/any unauthorized changes are made to the site/any unauthorized changes are made in the installation of the system. Improvement Permit with plat valid without expiration. Improvement Permit with site plan valid for sixty months Authorization to Construct is valid for a period equal to that of Improvement Permit – not to exceed sixty months.

Signed: Edward McCoy date 7-18-00 Installed by: Al Jackhoe

Improvement Permit by: STEVE HEDRICK date 7-15-2000 Operation Permit by: STEVE HEDRICK date 9-14-00

Authorization to Construct by: STEVE HEDRICK date 7-15-2000 Existing System Inspection by: date

HEALTH DEPT COPY WHITE OWNER COPY (FINAL) YELLOW OWNER COPY (INITIAL) PINK