IREDELL COUNTY HEALTH DEPARTMENT

STATESVILLE 704-878-5305 (1) MOORESVILLE 704-664-5281

IMPROVEMENT PERMIT / AUTHORIZATION TO CONSTRUCT / OPERATION PERMIT / EXISTING SYSTEM INSPECTION

PERMIT# 105123 PIN# 3794-71-4081 DATE 5-22-02

OWNER OR CONTRACTOR SILVERWAVE PROPERTIES PHONE: Business _____ Home 704-532-6527

ADDRESS 5551 MONROE ROAD, CHARLOTTE, NC 28212

LOCATION ISLAND FORD ROAD, TL GOBLE RD, TL MARISTONE DRIVE, LOT ON RIGHT IN CURVE

SUBDIVISION FEATHERSTONE BLOCK / SECTION III LOT 56 LOT AREA 1.67 ACRES SITE CLASS. PS DESIGN FLOW 360 L.T.A.R. 0.30 GPD/FT²

Septic Tank: 1000 Gallons; STB 1007 Date _____

Pump Tank: _____ Gallons; PT _____ Date _____

Pump Make: _____ Model EQ 40 Serial No. 300

Nitrification Field: No Fields 1 Square Feet 1200 Linear Feet ~~400~~

No Lines THREE Trench Width 36" Max Trench Bottom Depth 36" Gravel Depth 12"

☑ New System ☐ Repair System ☐ Authorization to Construct

System Description: CONVENTIONAL, GRAVITY

Repair System Description: ~~30%~~ REDUCTION, GRAVITY

Maintenance Agreement Required: ☐ Yes ☑ No

☐ House/Mod. Home No. Bedrooms 3

☑ Mobile Home No. Bathrooms 2

☐ Business No. Employees _____

☐ Other _____


☐ Slab ☑ Crawl Space ☐ Basement w/plumbing ☐ Basement wo/plumbing

Water Supply: ☑ Individual ☑ Public ☐ Community WELL


Comments:/Conditions: KEEP SYSTEM MAXIMUM FEASIBLE DISTANCE FROM WELL (90')

Comments:/Conditions: (1) AN "ACCEPTED" SYSTEM WAS INSTALLED USING 75 "QUICK-4" INFILTRATOR CHAMBERS (2) SEPTIC TANK WITH MARKER INSTALLED USING 1 ZABEL A1 FILTER

INITIAL SITE SKETCH

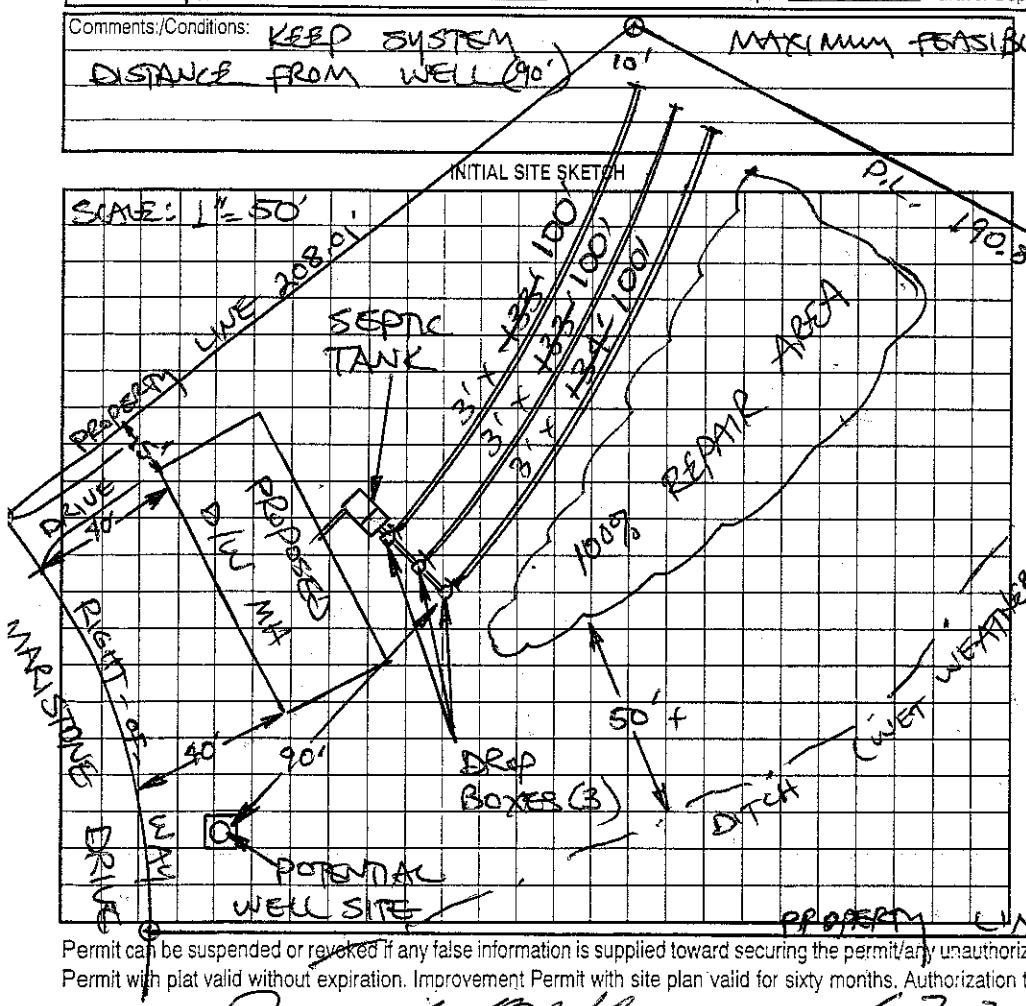

AS BUILT SKETCH

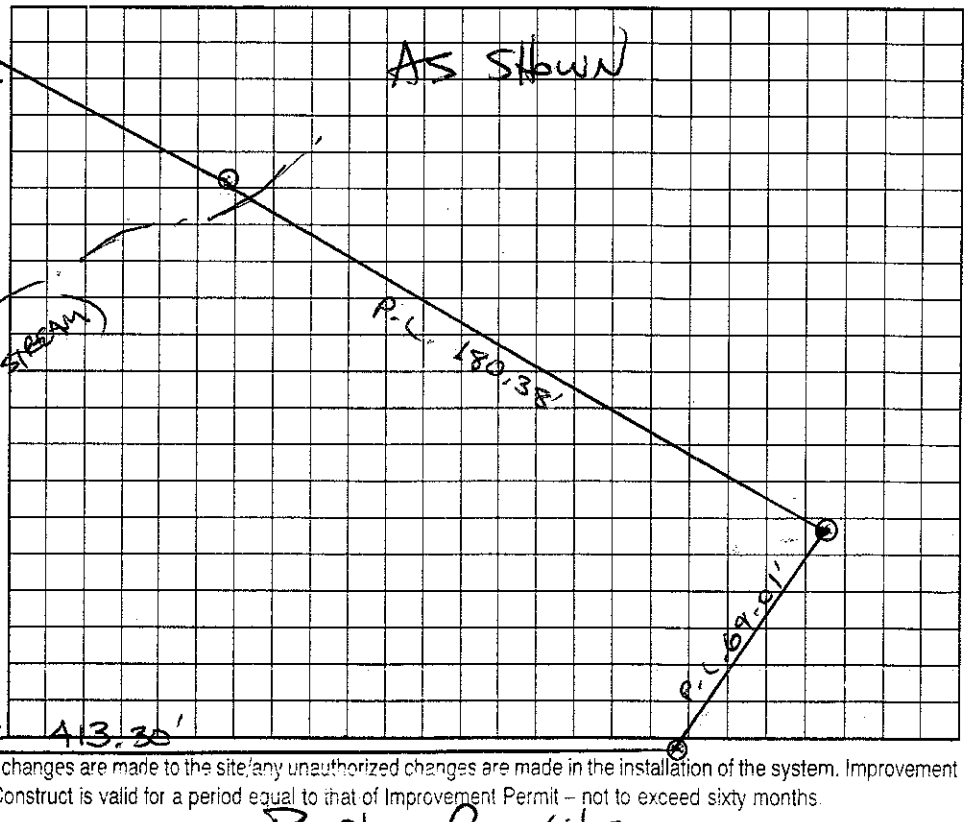

Permit can be suspended or revoked if any false information is supplied toward securing the permit/any unauthorized changes are made to the site/any unauthorized changes are made in the installation of the system. Improvement Permit with plat valid without expiration. Improvement Permit with site plan valid for sixty months. Authorization to Construct is valid for a period equal to that of Improvement Permit – not to exceed sixty months.

Signed: James J. Buckley date 6-7-02 Installed by: BOB'S BACKHOE

Improvement Permit by: STEVE HEDRICK date 5-22-02 Operation Permit by: STEVE HEDRICK date 6-9-06

Authorization to Construct by: STEVE HEDRICK date 5-22-02 Existing System Inspection by: _____ date _____

HEALTH DEPT. COPY: WHITE OWNER COPY (FINAL): YELLOW OWNER COPY (INITIAL): PINK