12 - 12:30 C Thompson

IREDELL COUNTY HEALTH DEPARTMENT

STATESVILLE 704-878-5305 MOORESVILLE 704-664-5281

IMPROVEMENT PERMIT / AUTHORIZATION TO CONSTRUCT / OPERATION PERMIT / EXISTING SYSTEM INSPECTION

PERMIT# 090002 PIN# 3794611170 DATE June 29, 2000

OWNER OR CONTRACTOR Lieutenant Housing Treatment PHONE: Business 532-6625 Home

ADDRESS 1090 Charlotte Hwy

LOCATION Island Ford Rd. TL Gable TL Marstone At end on Right

SUBDIVISION Featherstone BLOCK / SECTION 3 LOT 53 LOT AREA .69ac SITE CLASS PS DESIGN FLOW 360gpd L.T.A.R. .3

Septic Tank: 1000 Gallons: STB 1012 Date 4 15 00
Pump Tank: Gallons: PT Date
Pump Make: Model Serial No.
Nitrification Field: No Fields 1 Square Feet 1200 Linear Feet 400
No Lines 5@80' Trench Width 36" Max Trench Bottom Depth 36" Gravel Depth 12"

☑ New System ☐ Repair System Type: I II III IV V VI
System Description: Gravity Conventional
Repair System Description: Low Pressure Inovative -25%
Maintenance Agreement Required? ☐ Yes ☑ No Red.

☑ House/Mod. Home No. Bedrooms 3
☐ Mobile Home No. Bathrooms 2
☐ Business No. Employees
☐ Other
☐ Slab ☑ Crawl Space ☐ Basement w/plumbing ☐ Basement wo/plumbing


Water Supply: ☑ Individual ☐ Public ☐ Community

Comments/Conditions:


Comments/Conditions:

1" = 50'

INITIAL SITE SKETCH

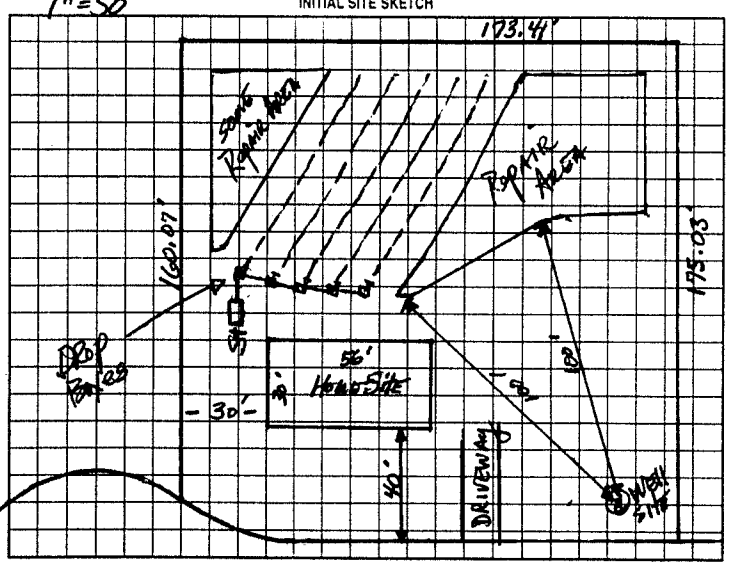

AS BUILT SKETCH

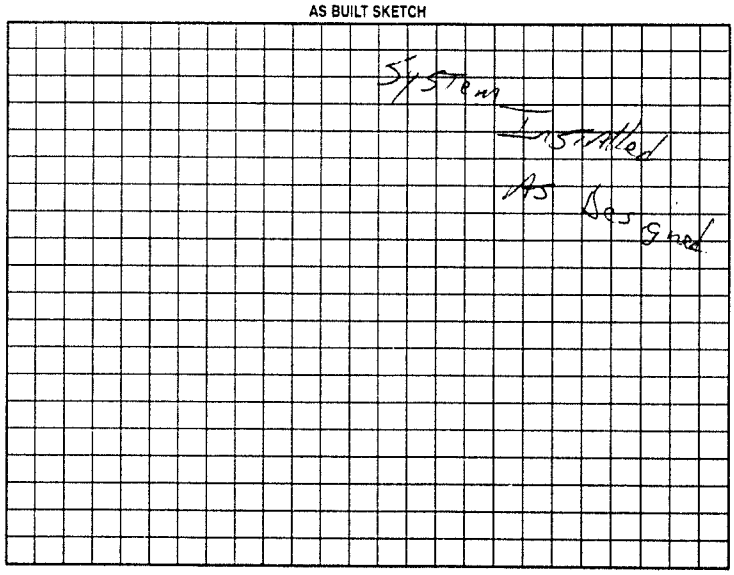

Permit can be suspended or revoked if any false information is supplied toward securing the permit/any unauthorized changes are made to the site/any unauthorized changes are made in the installation of the system. Improvement Permit with plat valid without expiration. Improvement Permit with site plan valid for sixty months. Authorization to Construct is valid for a period equal to that of Improvement Permit – not to exceed sixty months.

Signed: Chad Blackburn date

Improvement Permit by: Marvin B. Hinson, RS date 6-29-00

Authorization to Construct by: Marvin B. Hinson, RS date 6-29-00

Installed by: Craig Thompson

Operation Permit by: Lee Potter date July 17 2000

Existing System Inspection by: date

HEALTH DEPT. COPY: WHITE OWNER COPY (FINAL): YELLOW OWNER COPY (INITIAL): PINK