IREDELL COUNTY HEALTH DEPARTMENT

STATESVILLE 704-878-5305 MOORESVILLE 704-664-5281

IMPROVEMENT PERMIT / AUTHORIZATION TO CONSTRUCT / OPERATION PERMIT / EXISTING SYSTEM INSPECTION

PERMIT# 90057 PIN# 3794611170 PT DATE 7/13/00

OWNER OR CONTRACTOR SILVERWAVE PROP. PHONE: Business 532-6527 Home

ADDRESS 5551 MONROE RD. CHARLOTTE NC 28212

LOCATION OLD MOUNTAIN RD - TL ISLAND FORD - TL GOBLE RD - TL MARISTONE - AT END ON RT

SUBDIVISION FEATHERSTONE BLOCK / SECTION 3 LOT 52 LOT AREA .72AC SITE CLASS PS DESIGN FLOW 480GPD L.T.A.R. [redacted] .4 gpd/ft²

Septic Tank: 1000 Gallons; STB 1012 Date 4 4 2000
Pump Tank: Gallons; PT Date
Pump Make: Model Serial No.
Nitrification Field: No Fields 1 Square Feet 900 Linear Feet 300
No Lines 6@50' Trench Width 36" Max Trench Bottom Depth 36" Gravel Depth N/A

[x] New System [ ] Repair System Type: I, II, III, IV, V, VI
System Description: GRAVITY 25% REDUCTION
Repair System Description: PUMP SAME
Maintenance Agreement Required: [ ] Yes [x] No


[x] House/Mod. Home No. Bedrooms 4
[x] Mobile Home D/W No. Bathrooms 3
[ ] Business No. Employees
[ ] Other

[ ] Slab [x] Crawl Space [ ] Basement w/plumbing [ ] Basement wo/plumbing

Water Supply: [x] Individual [ ] Public [ ] Community


Comments/Conditions:

INITIAL SITE SKETCH

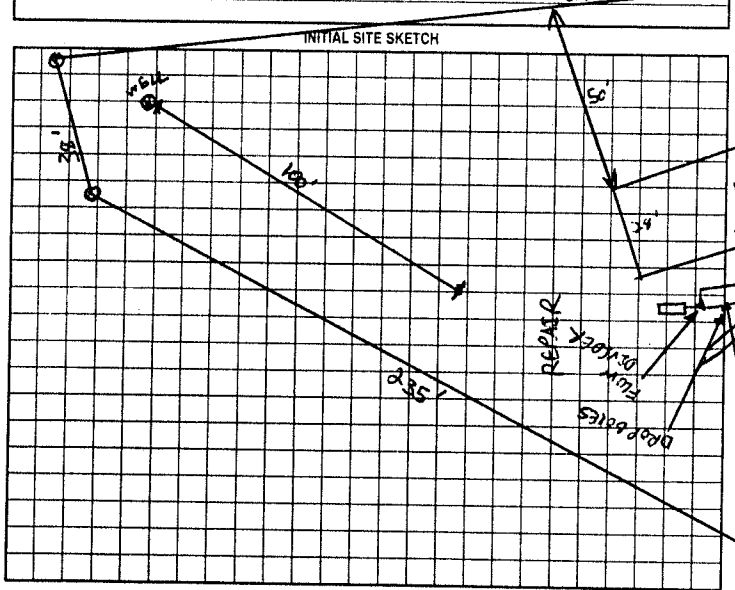

Comments/Conditions

AS BUILT SKETCH

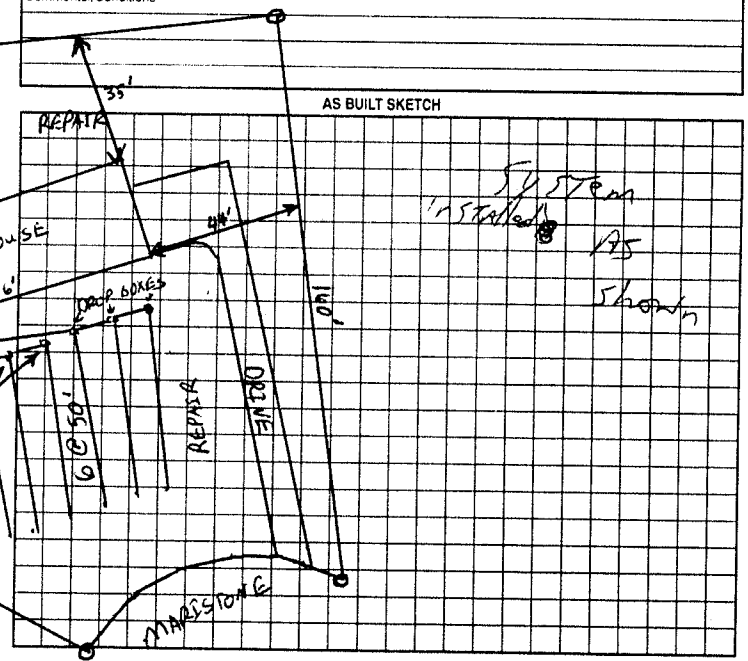

Permit can be suspended or revoked if any false information is supplied toward securing the permit/any unauthorized changes are made to the site/any unauthorized changes are made in the installation of the system. Improvement Permit with plat valid without expiration. Improvement Permit with site plan valid for sixty months. Authorization to Construct is valid for a period equal to that of Improvement Permit – not to exceed sixty months.

Signed: Bill Vassar date 7-14-00

Improvement Permit by: C. Blythe RS date 7/13/00

Authorization to Construct by: C. Blythe RS date 7/13/00

Installed by: Al Bitelhouse

Operation Permit by: C. Blythe date July 21 2000

Existing System Inspection by: date

HEALTH DEPT COPY: WHITE OWNER COPY (FINAL): YELLOW OWNER COPY (INITIAL): PINK