IREDELL COUNTY HEALTH DEPARTMENT

Statesville Phone TR 3-7271 Mooresville Phone NO 3-1271

PERMIT TO INSTALL SEPTIC TANK

Permit NO. "Pete Lore" Permit Date May 2 1969

Owner E. R. Pope Address R 6

Installed By C Hoke & Sons Address R 7


Location of Property East 1005 old Mtn. Rd. toward Sty Point Left 1523 dirt - 2nd on R. White Farm.

| Tank | | Capacity | | Length of Lines | | Fixtures | |
|---|---|---|---|---|---|---|---|
| Block | ( ) | 1000 | ( 4 | 225' | ( 4 | No. of Baths | ( 1 ) |
| Precast | ( 1 ) | 1250 | ( ) | 250' | ( ) | Dishwasher | ( ) |
| Adams. | | 1500 | ( ) | Other | | Garbage Grdr. | ( ) |
| | | Other | | | | Other | |

NOTIFY HEALTH DEPARTMENT AT LEAST EIGHT HOURS BEFORE TANK IS TO BE INSPECTED.

Final Inspection 19 Approved ( ) Disapproved ( )

Remarks Well 75 ft.

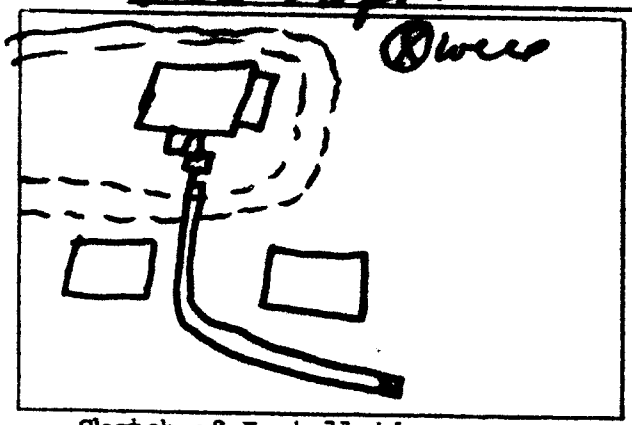


Sketch of Installation

Sanitarian