IREDELL COUNTY HEALTH DEPARTMENT

Statesville Phone TR 3-7271 Mooresville Phone NO 3-1271

PERMIT TO INSTALL SEPTIC TANK

Permit NO. "Pete Lore" Permit Date May 3 1969

Owner E. R. Pope Address R 6

Installed By C Hoke & Sons Address R 7


Location of Property East 1005 old Mtn. Rd. toward City Limit Left 1523 dist - 2nd on R. White Farm.

Tank		Capacity		Length of Lines		Fixtures	
Block	( )	1000	(✓)	225'	(✓)	No. of Baths	(1)
Precast	(✓)	1250	( )	250'	( )	Dishwasher	( )
Adams.		1500	( )	Other		Garbage Grdr.	( )
		Other				Other	

NOTIFY HEALTH DEPARTMENT AT LEAST EIGHT HOURS BEFORE TANK IS TO BE INSPECTED.

Final Inspection 19 Approved ( ) Disapproved ( )

Remarks Well 75 ft.

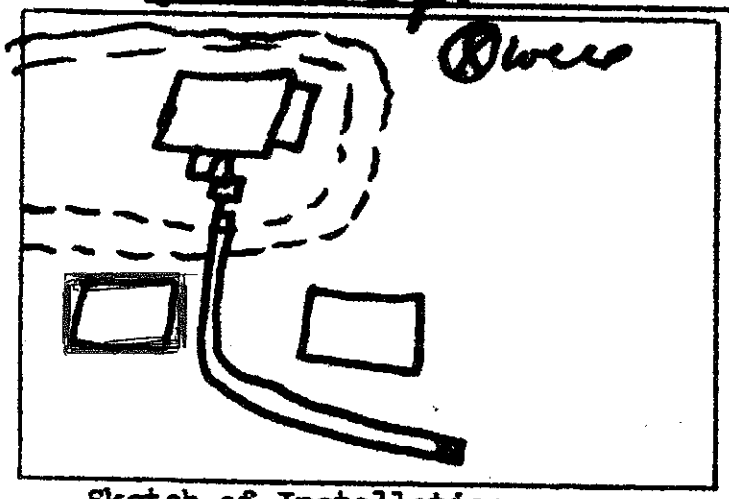

Sketch of Installation

Location of the proposed ACC. BLDG/GARAGE addition does not appear to impact the existing on-site septic system.**NOTE: KEEP MIN. 5' FROM SYSTEM

R. STEVE HENDRICK REHS

Date: NOVEMBER 20, 2012

ICHD-Environmental Health Division

Sanitarian