IREDELL COUNTY HEALTH DEPARTMENT

STATESVILLE 704-878-5305 MOORESVILLE 704-664-5281

49424

IMPROVEMENT PERMIT / CERTIFICATE OF COMPLETION / OPERATION PERMIT / EXISTING SYSTEM INSPECTION

PROPERTY DESCRIPTION NO. 12818 DATE 12-8-93 TAX MAP NO. 8N-A-80

OWNER OR CONTRACTOR Ricky Shook PHONE: Business _____ Home _____ Watershed: ☐ Yes ☑ No

ADDRESS _____

LOCATION I40W TR old Mtn. Rd. TL Island Ford Rd. Lot approx. 1 mile on R just before bridge

SUBDIVISION NA BLOCK / SECTION — LOT — LOT AREA 9.5 acres SITE CLASS. P.S. DESIGN FLOW 360 L.T.A.R. .4 gpd/ft²

Septic Tank: 1000 Gallons; STB 1012 Date 8-24-93

Pump Tank: — Gallons; PT — Date —

Pump Make: — Model — Serial No. —

Nitrification Field: No Fields 1 Square Feet 900 Linear Feet 300'

No Lines 3 Trench Width 36" Max Trench Bottom Depth 36" Gravel Depth 12"

☑ New System ☐ Repair System Type: I, II, III, IV, V, VI

System Description: conventional, gravity fed.

Repair System Description: not established when permitted

Maintenance Agreement Required: ☐ Yes ☑ No

☑ House/Mod. Home No. Bedrooms 3

☐ Mobile Home No. Bathrooms 2

☐ Business No. Employees —

☐ Other _____


☐ Slab ☐ Crawl Space ☐ Basement w/plumbing ☑ Basement wo/plumbing

Water Supply: ☑ Individual ☐ Community ☐ Public


Comments:

Comments: 100% Repair Area not issued or established when permitted. Some available repair area in front of home.

INITIAL SITE SKETCH

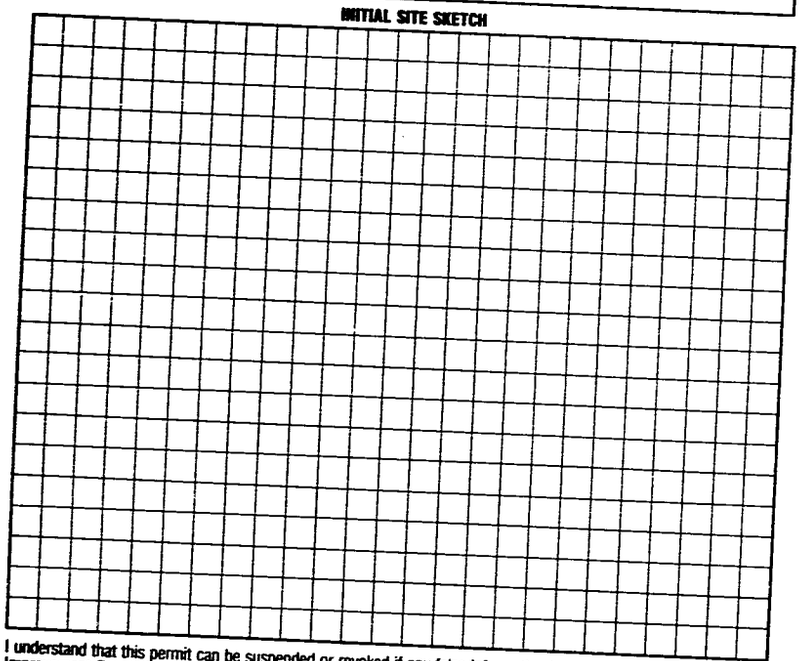

AS BUILT SKETCH

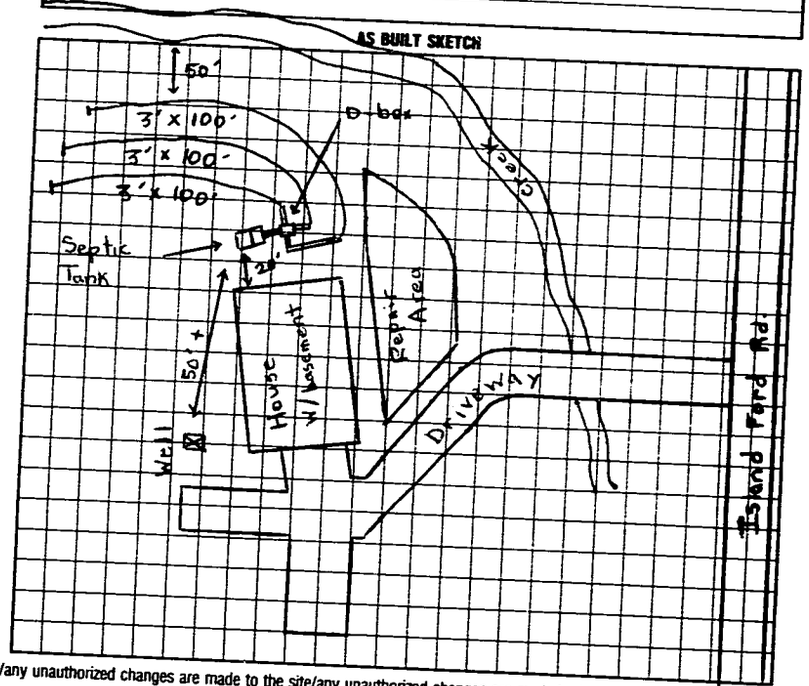

I understand that this permit can be suspended or revoked if any false information is supplied toward securing the permit/any unauthorized changes are made to the site/any unauthorized changes are made in the installation of the system. Improvement Permit is valid for 60 months from date of issuance.

Signed: _____

Improvement Permit by: Steve Brown date 8-11-91

Existing System Inspection by: _____ date _____

Installed by: James Hudler

Certificate of Completion by: Michael L. Dennis date 12-8-93

Operation Permit by: _____ date _____

HEALTH DEPT. COPY: WHITE INSPECTION COPY (FINAL): GREEN OWNER COPY (FINAL): YELLOW INSPECTION COPY (INITIAL): PINK OWNER COPY (INITIAL): GOLD