IREDELL COUNTY HEALTH DEPARTMENT

STATESVILLE 704-878-5305 MOORESVILLE 704-664-5281

IMPROVEMENT PERMIT / AUTHORIZATION TO CONSTRUCT / OPERATION PERMIT / EXISTING SYSTEM INSPECTION

PERMIT# Repair PIN# DATE 4-28-99

OWNER OR CONTRACTOR Shawn Pogue PHONE: Business Home 871-0231

ADDRESS 189 Old Miller Rd Statesville old

LOCATION OMR 1L Island Ford Rd TR Miller house on (L)

SUBDIVISION BLOCK / SECTION LOT LOT AREA SITE CLASS 8/5 DESIGN FLOW 480 L.T.A.R. Existing

Septic Tank: 1000 Exist Gallons; STB Date

Pump Tank: Gallons; PT Date

Pump Make: Model Serial No.

Nitrification Field: No Fields 1 Square Feet Linear Feet 400+

No Lines 7 Trench Width 36in Max Trench Bottom Depth 36in

☐ New System ☒ Repair System Type: I. (II) III. IV. V. VI

System Description:

Repair System Description: Gravity Conventional

Maintenance Agreement Required: ☐ Yes ☒ No

Gravel Depth 12in ☐ Slab ☒ Crawl Space ☐ Basement w/plumbing ☒ Basement wo/plumbing

☒ House/Mod. Home No. Bedrooms 4

☐ Mobile Home No. Bathrooms 2

☐ Business No. Employees


☐ Other

Water Supply: ☒ Individual ☐ Public ☐ Community


Comments/Conditions: This permit serves as 'Notice of Violation'. Install 7 lines on contour. Check Sanitary Tee/Baffle if needed. (recommend filter in Tank)

Comments/Conditions:

INITIAL SITE SKETCH

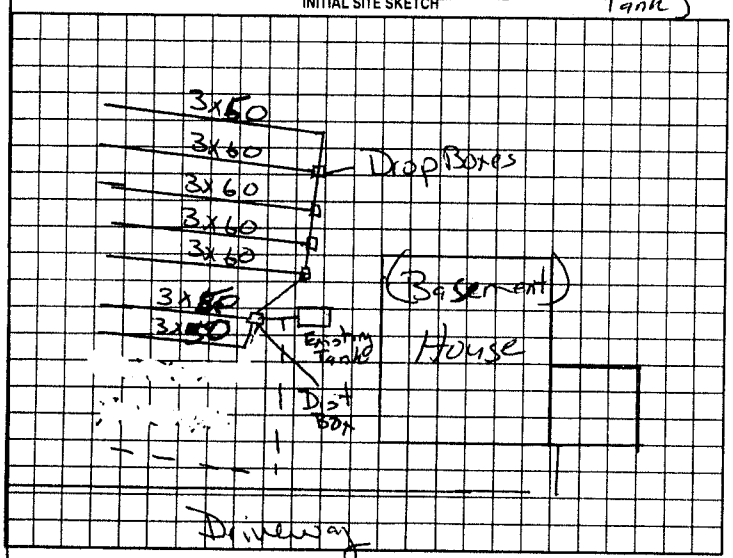

AS BUILT SKETCH

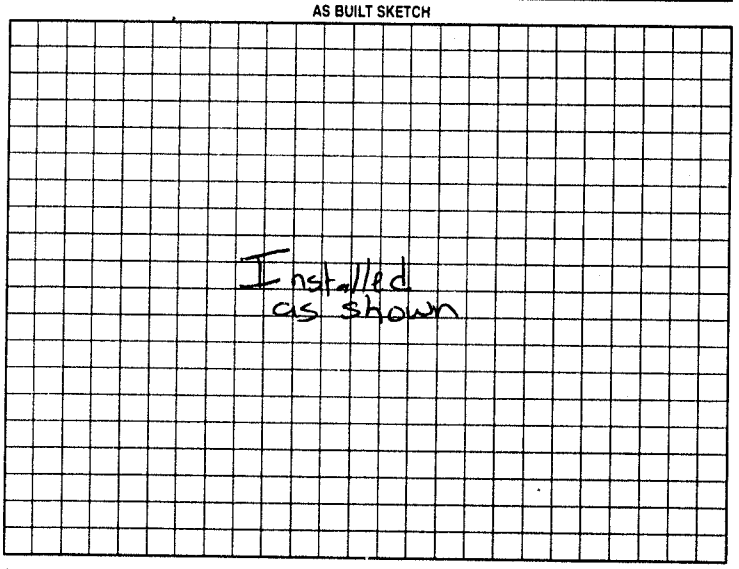

Permit can be suspended or revoked if any false information is supplied toward securing the permit/any unauthorized changes are made to the site/any unauthorized changes are made in the installation of the system. Improvement Permit with plat valid without expiration. Improvement Permit with site plan valid for sixty months. Authorization to Construct is valid for a period equal to that of Improvement Permit – not to exceed sixty months.

Signed: Shawn M. Pogue date 4-28-99

Improvement Permit by: Mark C Ortiz RS date 4-28-99

Authorization to Construct by: Mark C Ortiz RS date 4-28-99

Installed by: Forest Shuford

Operation Permit by: Mark C Ortiz RS date 7-1-99

Existing System Inspection by: date

HEALTH DEPT COPY WHITE OWNER COPY (FINAL) YELLOW OWNER COPY (INITIAL) PINK