IREDELL COUNTY HEALTH DEPARTMENT

STATESVILLE 704-878-5305 MOORESVILLE 704-664-5281

IMPROVEMENT PERMIT / AUTHORIZATION TO CONSTRUCT / OPERATION PERMIT / EXISTING SYSTEM INSPECTION

PERMIT # 159987 PIN # 3795-08-1924 DATE 11 March 10

OWNER or APPLICANT Capote Builders PHONE: Business (704) 400-5481 Home:

OWNER or APPLICANT ADDRESS 5426 Capote Rd. Maiden, N.C.

LOCATION / DIRECTIONS Old Mtn. Rd. Turn Pressley Farm Rd. TR Sister Ln. Go to end - on Rt.

SUBDIVISION William Waugh Jr. Est. BLOCK / SECTION LOT # 3 LOT AREA 1.86ac. DESIGN FLOW 360 gpd L.T.A.R. 0.25 gpd/ft²

Septic Tank 1000 Gallons: STB 760 Date 10-17-09

Pump Tank Gallons: PT Date

Pump Make Model Serial #

Nitrification Field No Fields 1 No Lines 3 Linear Feet 360

Trench Width 36" Max. Trench Bottom Depth 36" Gravel Depth N/A

☑ New System ☐ Repair ☐ Expansion System Type I II (III) IV V VI

System Description: 25% Reduction

Repair System Description: 25% Reduction

Maintenance Agreement Required ☐ YES ☑ NO

☑ GRAVITY ☐ PRESSURE

☑ Residence No. Bedrooms 3

☐ Business No. Persons

☐ Other No. Employees

☐ Slab ☑ Crawl Space


☐ Basement w/plumbing ☐ Basement w/o plumbing

Water Supply: ☑ Private ☐ Public ☐ Community


Comments / Conditions: Follow Contour / Keep well 100' from septic system and repair areas / Keep above terrace and headslope /

Comments / Conditions: Pulp/lock Filter Tee installed

INITIAL SITE SKETCH

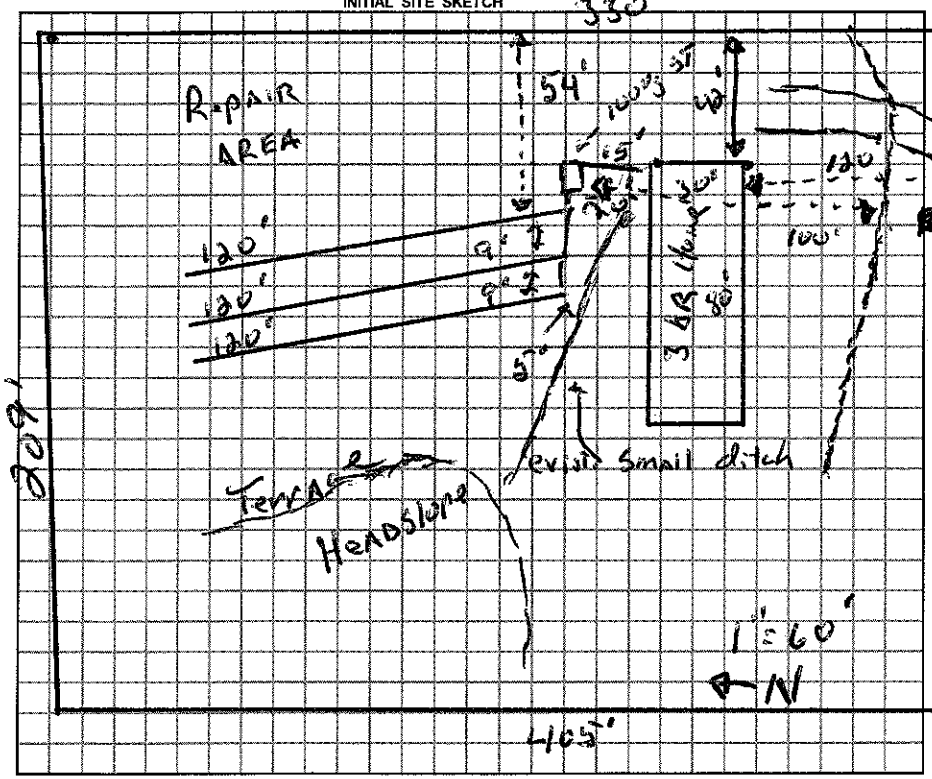

AS BUILT SKETCH

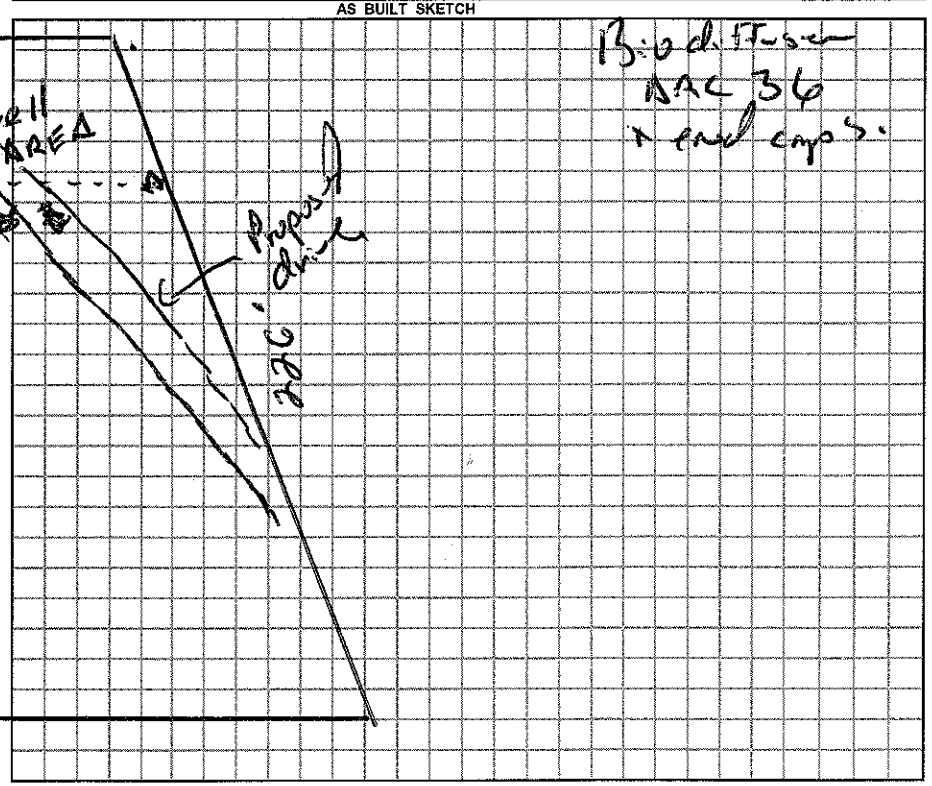

Permit can be suspended or revoked if any false information is supplied toward securing the permit / any unauthorized changes are made to the site / any unauthorized changes are made in the installation of the system.

☐ *IMPROVEMENT PERMIT w / plat valid without expiration.* ☑ *IMPROVEMENT PERMIT w / site plan valid for 60 mos.* ☑ *AUTHORIZATION TO CONSTRUCT valid for period equal to IMPROVEMENT PERMIT-not to exceed 60 mo.*

Owner / Applicant Signature: Date 12 March 10

Improvement Permit by: R.S. Date 11 March 10

Authorization to Construct by: R.S. Date 11 March 10

Installed by: Tim Abee

Operation Permit by: R.S. Date: 14 Apr 10

Existing System Inspected by: Date:

YOU SHOULD CONTACT A LOCATOR SERVICE PRIOR TO ANY EXCAVATION.

WHITE COPY Environmental Health YELLOW COPY (Final) Owner / Applicant PINK COPY (Initial) Owner / Applicant