IREDELL COUNTY HEALTH DEPARTMENT

STATESVILLE 704-878-5305 (a) (a) MOORESVILLE 704-664-5281

IMPROVEMENT PERMIT / AUTHORIZATION TO CONSTRUCT / OPERATION PERMIT / EXISTING SYSTEM INSPECTION

PERMIT # 156733 PIN # 3795-09-1885 DATE 9 June 09

OWNER or APPLICANT Circle Hall Enterprises, Inc PHONE: Business (704) 664-6400 Home:

OWNER or APPLICANT ADDRESS P.O. Box 3397 Mooresville, NC

LOCATION / DIRECTIONS Old MTN. Rd. Turn onto Cain Rd. TL Grain Rd. TR Bunny LN.

SUBDIVISION Cain Road Estates BLOCK / SECTION LOT # 43 LOT AREA DESIGN FLOW 360 g/d L.T.A.R. 0.34 Ft²/d

Septic Tank 1000 g Gallons: STB 1000 Date 7-13-09
Pump Tank Gallons: P T Date
Pump Make Model Serial #
Nitrification Field No Fields 1 No Lines 4 Linear Feet 300
Trench Width 36" Max. Trench Bottom Depth 36" Gravel Depth N/A ☑ GRAVITY ☐ PRESSURE

☑ New System ☐ Repair ☐ Expansion System Type I II III IV V VI
System Description: 25% Reduction
Repair System Description: 50% Reduction LPP
Maintenance Agreement Required ☐ YES ☑ NO

☑ Residence No. Bedrooms 3
☐ Business No. Persons
☐ Other No. Employees
☐ Slab ☑ Crawl Space
☐ Basement w/plumbing ☐ Basement w/o plumbing

Water Supply: ☐ Private ☑ Public ☐ Community

Comments / Conditions: Follow contour / Hunter Setbacks. Divert Run off away from system Area

Comments / Conditions: Septic Map Red Log Info

INITIAL SITE SKETCH

Please see Attached Site sketch.

AS BUILT SKETCH

9-1-09

Permit can be suspended or revoked if any false information is supplied toward securing the permit / any unauthorized changes are made to the site / any unauthorized changes are made in the installation of the system.

☐ IMPROVEMENT PERMIT w / plat valid without expiration ☑ IMPROVEMENT PERMIT w / site plan valid for 60 mos. * ☑ AUTHORIZATION TO CONSTRUCT valid for period equal to IMPROVEMENT PERMIT-not to exceed 60 mo. 9-1-09

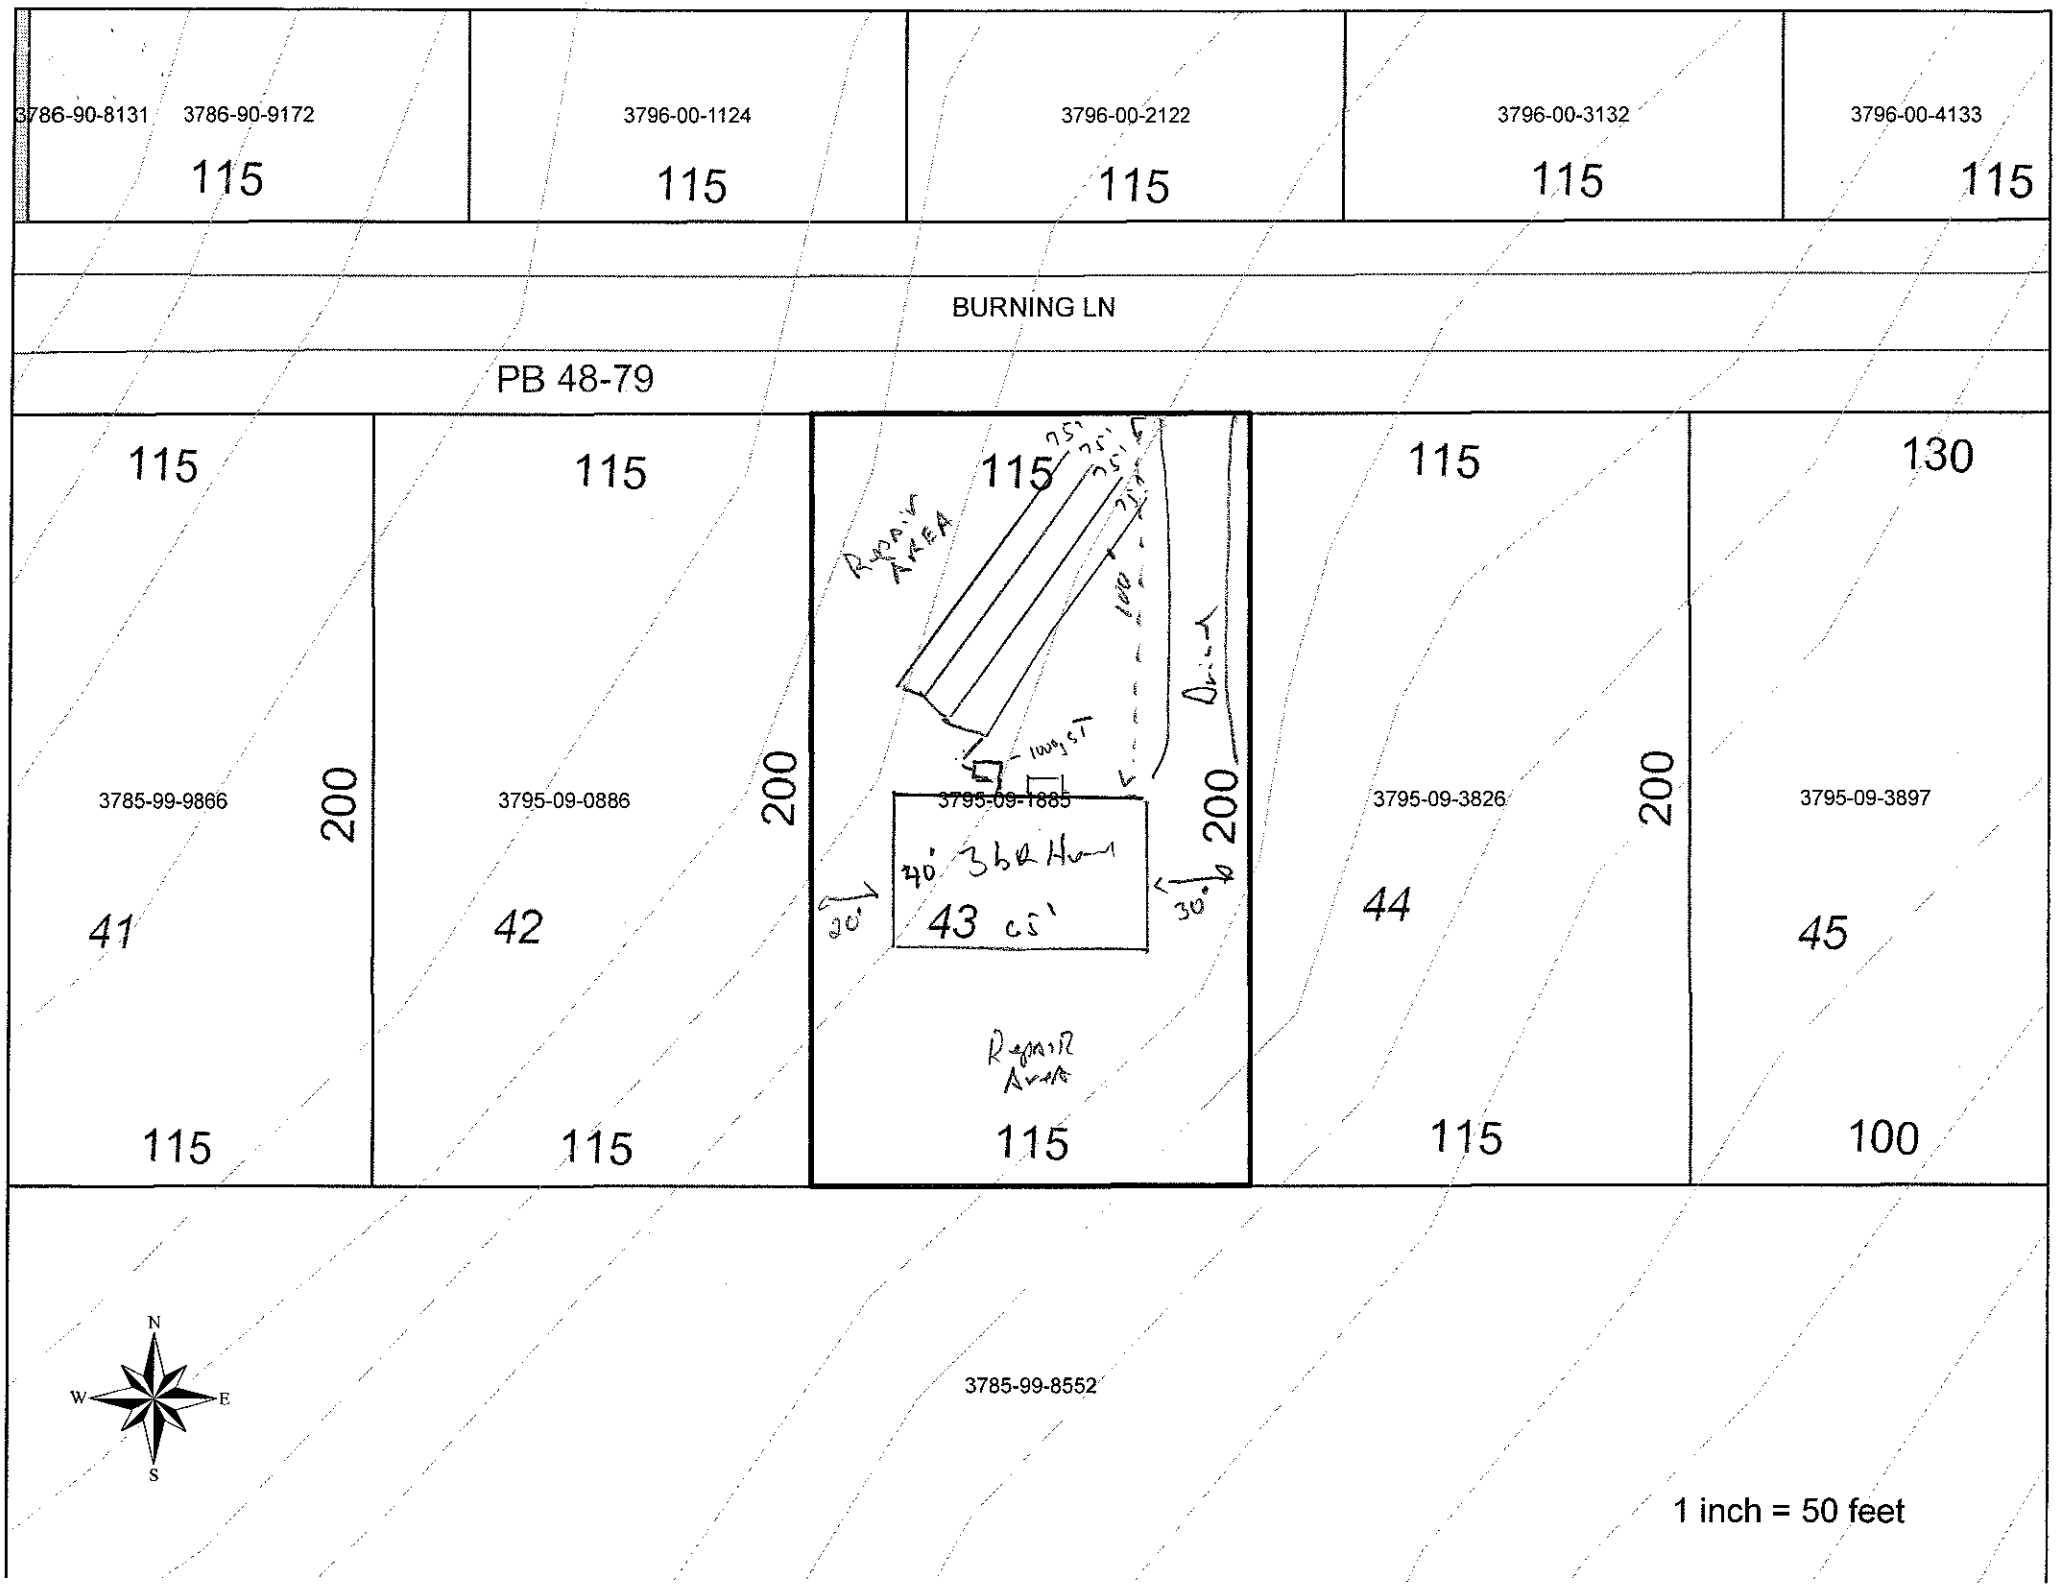
Owner / Applicant Signature: Date 7/06/09 Installed by: Tommy Cothren

Improvement Permit by: R.S. Date 9 June 09 Operation Permit by: Date: 10-19-09

Authorization to Construct by: Date 9-1-09 Existing System Inspected by: Date:

YOU SHOULD CONTACT A LOCATOR SERVICE PRIOR TO ANY EXCAVATION!

WHITE COPY Environmental Health YELLOW COPY (Final) Owner / Applicant PINK COPY (Initial) Owner / Applicant


3786-90-8131
3786-90-9172
115
3796-00-1124
115
3796-00-2122
115
3796-00-3132
115
3796-00-4133
115
BURNING LN
PB 48-79
115
115
115
115
130
3785-99-9866
200
3795-09-0886
200
3795-09-1885
200
3795-09-3826
200
3795-09-3897
41
42
43
44
45
115
115
115
115
100
Repair Area
40' 3bR Home
20'
30'
3785-99-8552
N
W
E
S
1 inch = 50 feet