2:00

IREDELL COUNTY HEALTH DEPARTMENT - *ENVIRONMENTAL HEALTH* ☑ STATESVILLE OFFICE 704-878-5305 ☐ MOORESVILLE OFFICE 704-664-5281

IMPROVEMENT PERMIT / AUTHORIZATION TO CONSTRUCT / OPERATION PERMIT / EXISTING SYSTEM INSPECTION

PERMIT # 16827 7 PIN # 3795-20-6309 DATE 12-30-11

OWNER David Holman APPLICANT: SAME PHONE: Home/Cell # 704 838-1200 Business # 704-252-7475

SITE ADDRESS 162 Linden Loop OWNER / APPLICANT ADDRESS

SITE DIRECTIONS I-40 to (R) on Old Mtn Rd., go 3 mile, (L) on New Sterling Rd. (R) Linden Loop, on (R) from Salvage Yard

SUBDIVISION n/a BLOCK / SECTION n/a LOT # n/a LOT AREA 1.55 DESIGN FLOW 360 L.T.A.R. .3

Septic Tank 1000 Gallons: STB 1012 Date 9-6-11 ☒ New System ☐ Repair ☐ Expansion System Type I II (III) IV V VI ☒ Residence No. Bedrooms 3 Water Supply

Pump Tank ____ Gallons: P T ____ Date ____ System Description: 25% Reduction ☐ Business No. Persons ____ ☒ Private

Pump Make ____ Model ____ Serial # ____ Repair System Description: 25% Reduction ☐ Other No. Employees ____ ☐ Public


No. Nitrification Fields: 1 No. Lines ____ Linear Feet 300 Maintenance Agreement Required ☐ YES ☒ NO ☐ Slab ☒ Crawl Space ☐ Community

Trench Width 36" Max. Trench Bottom Depth 36" Gravel Depth n/a ☒ GRAVITY ☐ PRESSURE ☐ Basement w/plumbing ☐ Basement w/o plumbing


Comments / Conditions

(3)

INITIAL SITE SKETCH

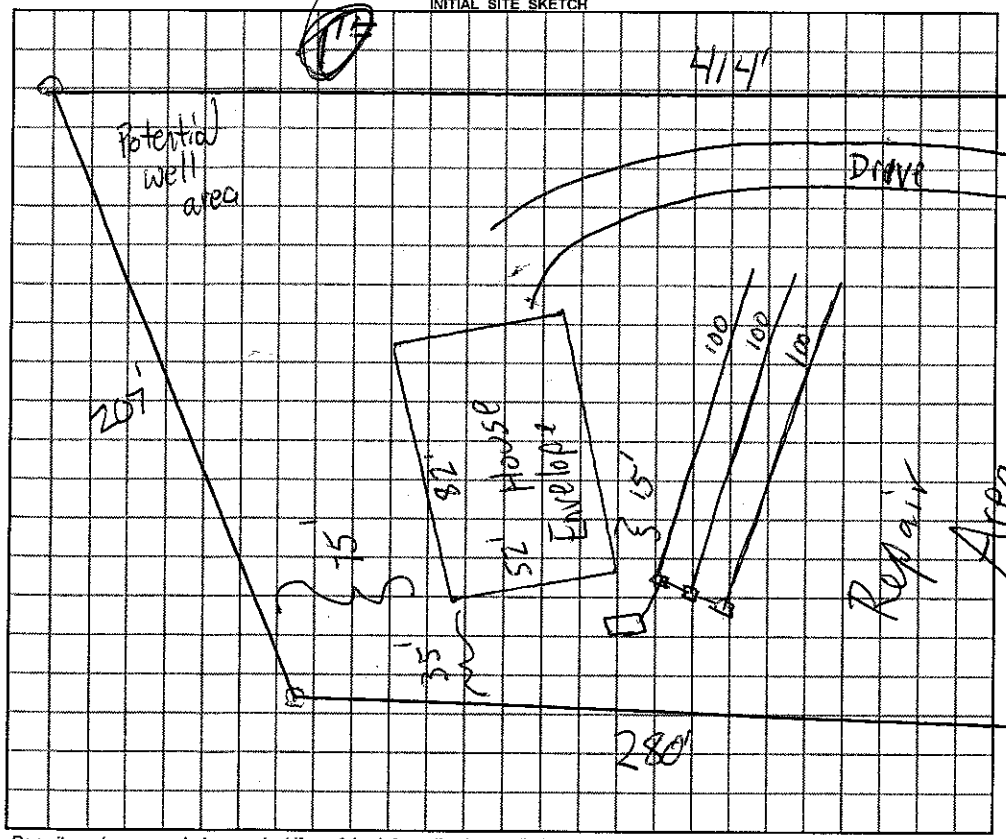

AS BUILT SKETCH

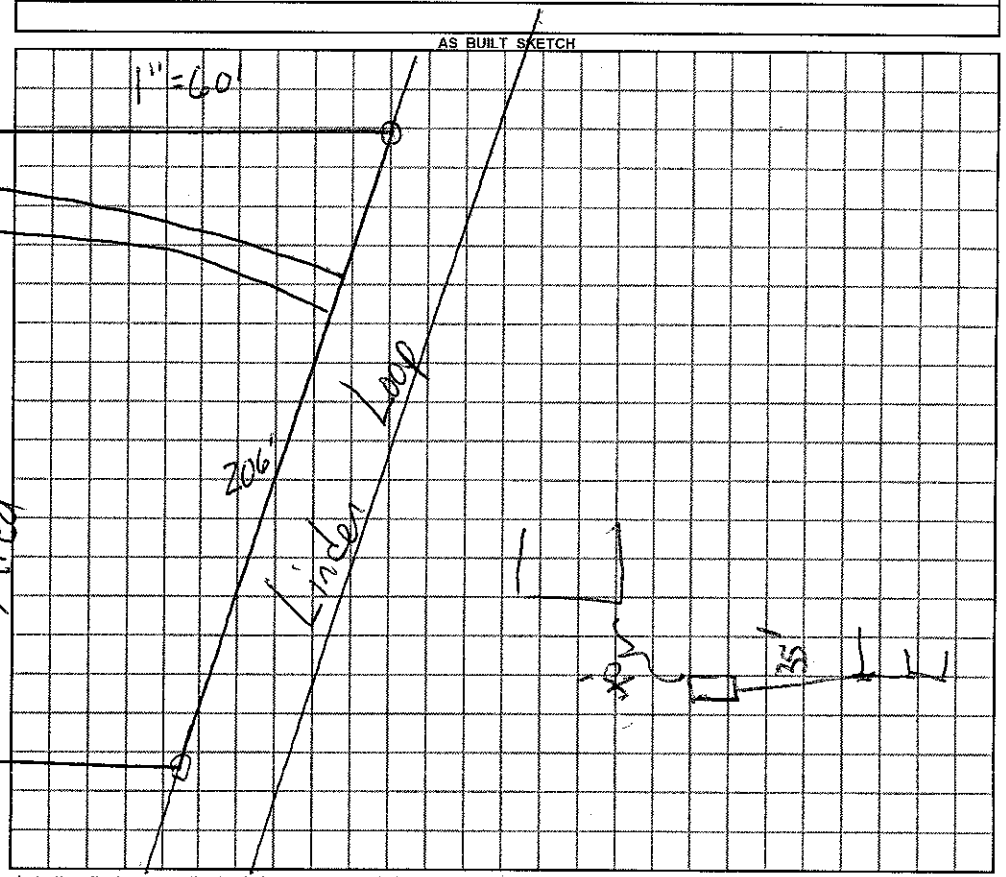

Permit can be suspended or revoked if any false information is supplied toward securing the permit / any unauthorized changes are made to the site / any unauthorized changes are made in the installation of the system.

☐ ***IMPROVEMENT PERMIT*** *with plat valid without expiration.* ☒ ***IMPROVEMENT PERMIT*** *with plat valid without expiration.* ***site plan valid 60 mo.*** ☒ ***AUTHORIZATION TO CONSTRUCT*** valid for period equal to IMPROVEMENT PERMIT--not to exceed 60 mo.

Owner / Applicant Signature: David W. Holman Date 2-15-12 Installed by: Groundbreakers

IMPROVEMENT PERMIT by: James REHS Date 12-30-11 OPERATION PERMIT by: James REHS Date 3-13-12

AUTHORIZATION TO CONSTRUCT by: James REHS Date 12-30-11 Existing System Inspected by: REHS Date

YOU SHOULD CONTACT A LOCATOR SERVICE PRIOR TO ANY EXCAVATION

White Copy – Environmental Health YELLOW COPY (Final) Owner / Applicant PINK COPY (Initial) Owner / Applicant