IREDELL COUNTY HEALTH DEPARTMENT

Statesville Phone TR 3-7271 Mooresville Phone NO 3-1271

PERMIT TO INSTALL SEPTIC TANK

Permit NO. _____ Permit Date Oct 31 – 1961

Owner David Sides Address Old Mtn. Rd.

Installed By CLYDE HOKE Address _____


Location of Property Stony Point N.C. Old Mtn. Rd. before Pressley Farm Rd.

Tank	Capacity		Length of Lines		Fixtures	
Block ( )	800	( )	150'	( )	No. of Baths	(3)
Precast (✓)	900	( )	175'	( )	Dishwasher	( )
Lash	1000	(✓)	200'	( )	Garbage Grdr.	( )
	1100	( )	225'	(✓)	Auto-Washer	(✓)
	1200	( )	250'	( )	Other	
	Other		Other			

NOTIFY HEALTH DEPARTMENT AT LEAST EIGHT HOURS BEFORE TANK IS TO BE INSPECTED.

Final Inspection Oct 31 – 1961 Approved (✓) Disapproved ( )

Remarks well 100'

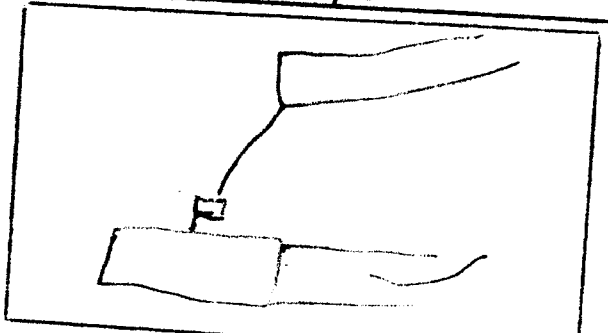

Sketch of Installation Case

Rat

Sanitarian