IREDELL COUNTY HEALTH DEPARTMENT

STATESVILLE 704-878-5305 MOORESVILLE 704-664-5281

IMPROVEMENT PERMIT / AUTHORIZATION TO CONSTRUCT / OPERATION PERMIT / EXISTING SYSTEM INSPECTION

PERMIT# 140002 PIN# 3795-33-2203 DATE 23 January 07

OWNER OR APPLICANT Charles & Wendy Pope PHONE: Business (704) 437-4494 Home

ADDRESS 359 Linden Loop Stony Point, N.C. 28678

LOCATION Hwy 90W TR Old Mtn Rd TL New Sterling TR Linden - First on Rt.

SUBDIVISION BLOCK / SECTION LOT LOT AREA 11.76ac. SITE CLASS. PS DESIGN FLOW 360gpd L.T.A.R. .35gpd/SF

* Septic Tank: 1000 Gallons: STB 1012 Date 10-26-07
Pump Tank: Gallons: PT Date
Pump Make: Model Serial No.
Nitrification Field: No Fields Square Feet Linear Feet
No Lines Trench Width Max Trench Bottom Depth Gravel Depth ☑ Gravity ☐ Pressure

☐ New System ☐ Repair ☐ Expansion System Type: I II III IV V VI
System Description:
Repair System Description:
Maintenance Agreement Required: ☐ Yes ☑ No

☑ House/Mod. Home No. Bedrooms 4
☐ Mobile Home No. Persons
☐ Business No. Employees
☐ Other

Water Supply: ☑ Individual ☐ Public ☐ Community

☐ Slab ☐ Crawl Space ☐ Basement w/plumbing ☑ Basement wo/plumbing

Comments:/Conditions:


* Install new 1000g ST to existing system.

Comments:/Conditions:

T-OF-tk Fill available
ST has marker

INITIAL SITE SKETCH

AS BUILT SKETCH

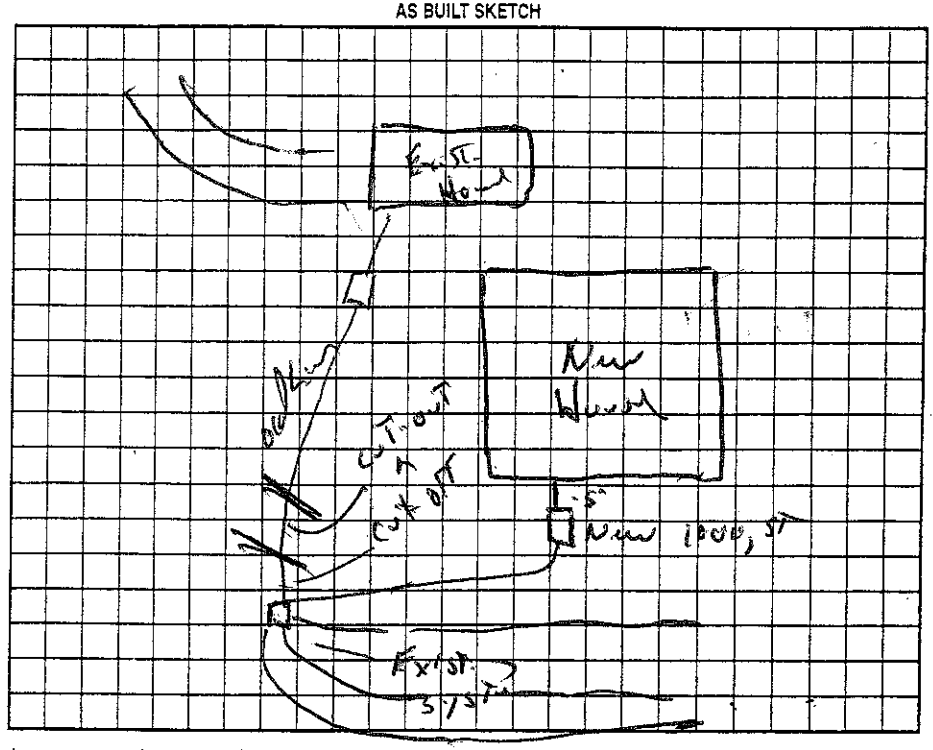

Permit can be suspended or revoked if any false information is supplied toward securing the permit/any unauthorized changes are made to the site/any unauthorized changes are made in the installation of the system. Improvement Permit with plat valid without expiration ☐ Improvement Permit with site plan valid for sixty months ☐ Authorization to Construct is valid for a period equal to that of Improvement Permit – not to exceed sixty months.

Signed: Wendy Pope date 2-7-07

Improvement Permit by: date

Authorization to Construct by: R.S. date 23 Jan. 07

Installed by:

Operation Permit by: R.S. date 22 Jun. 08

Existing System Inspection by: R.S. date 23 January 07

HEALTH DEPT. COPY: WHITE OWNER COPY (FINAL): YELLOW OWNER COPY (INITIAL): PINK