IREDELL COUNTY HEALTH DEPARTMENT

Statesville Phone TR 3-7271 Mooresville Phone No. 664-5281

PERMIT TO INSTALL SEPTIC TANK

Permit No. 222 Permit Date 2-23 1973

Owner ROBERT BOWERS Address STATESVILLE, N.C.

Installed By HERMAN GIBSON Address STATESVILLE, N.C.


Location of Property OLD MOUNTAIN Rd - LEFT ON NEW STERLING Ch Rd - GO 1 MILE HOUSE ON LEFT.

Tank		Capacity		Length of Lines		Fixtures	
Block	( )	1000	(✓)	225'	( )	No. of Baths	(2)
Precast	(✓)	1250	( )	250'	( )	Dishwasher	(1)
		1500	( )	Other 261		Garbage Grdr.	( )
		Other				Other	

NOTIFY HEALTH DEPARTMENT AT LEAST EIGHT HOURS BEFORE TANK IS TO BE INSPECTED.

Final Inspection 2-23 1973 Approved (✓) Disapproved ( )

Remarks well

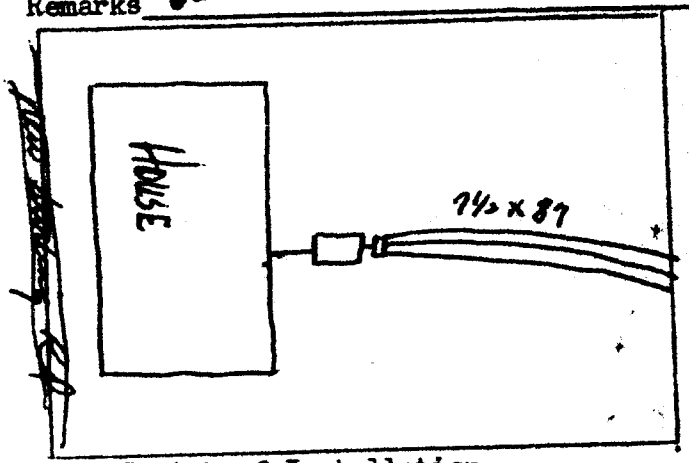

Sketch of Installation

Glenn Fox Jr.

Sanitarian