IREDELL COUNTY HEALTH DEPARTMENT

STATESVILLE 704-878-5305 MOORESVILLE 704-664-5281

IMPROVEMENT PERMIT / AUTHORIZATION TO CONSTRUCT / OPERATION PERMIT / EXISTING SYSTEM INSPECTION

PERMIT# 89886 PIN# 3795471543 DATE June 19 2000

OWNER OR CONTRACTOR David Sikes/Heather PHONE: Business 876-6847 Home

ADDRESS PO Box 6256 Statesville

LOCATION Old NC Rd N/L on Right just PAST Maricle Farm Rd LAST LOT NEXT TO BRICK House

SUBDIVISION Stoneydell BLOCK / SECTION LOT 5 LOT AREA .53 SITE CLASS PJ DESIGN FLOW 360 L.T.A.R. .33

Septic Tank: 1030 Gallons; STB 1007 Date 5-8-00 ☒ New System ☐ Repair System Type: I ☒ II, III, IV, V, VI ☐ House/Mod. Home No. Bedrooms 3

Pump Tank: Gallons; PT Date System Description: Conv. GRAVITY ☒ Mobile Home DW No. Bathrooms 2

Pump Make: Model Serial No. Repair System Description: Pump Reduction ☐ Business No. Employees

Nitrification Field: No Fields 1 Square Feet 1090 Linear Feet 365 Maintenance Agreement Required: ☐ Yes ☒ No ☐ Other


Lines 5 Trench Width 36" Max Trench Bottom Depth 36" Gravel Depth 12" ☐ Slab ☒ Crawl Space ☐ Basement w/plumbing ☐ Basement wo/plumbing

Water Supply: ☐ Individual ☒ Public ☐ Community

Comments/Conditions: INSTALL on CONTOUR

Comments/Conditions: SEPTIC TANK W/ MARKER INSTALLED USING "POLYLOK" FILTER

INITIAL SITE SKETCH

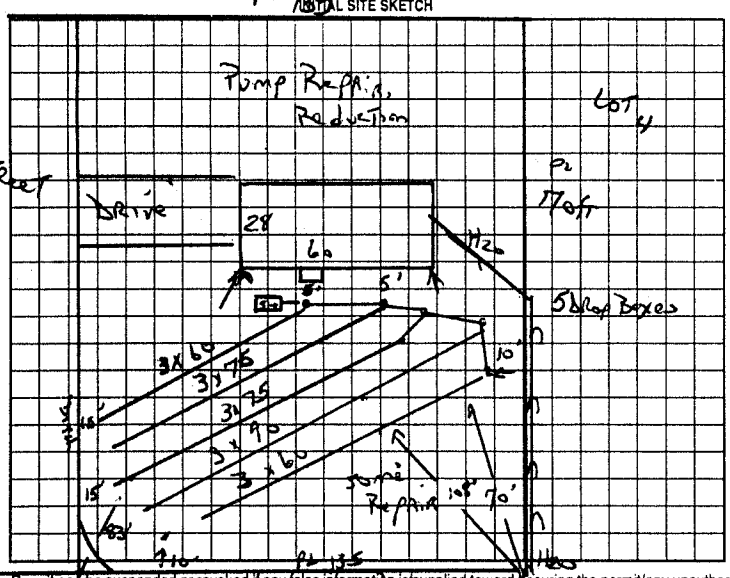

AS BUILT SKETCH

SYSTEM INSTALLED ACCORDING TO INITIAL SITE SKETCH

Permit can be suspended or revoked if any false information is supplied toward securing the permit/any unauthorized changes are made to the site/any unauthorized changes are made in the installation of the system. Improvement Permit with plat valid without expiration. Improvement Permit with site plan valid for sixty months. Authorization to Construct is valid for a period equal to that of Improvement Permit – not to exceed sixty months.

Signed: [signature] date 6/19/00 Installed by: Tommy Cothren

Improvement Permit by: J. Potter date June 19 2000 Operation Permit by: Steve Hedrick date 7-3-00

Authorization to Construct by: J. Potter date June 19 2000 Existing System Inspection by: date

HEALTH DEPT. COPY: WHITE OWNER COPY (FINAL): YELLOW OWNER COPY (INITIAL): PINK