IREDELL COUNTY HEALTH DEPARTMENT

STATESVILLE 704-878-5305 MOORESVILLE 704-664-5281

IMPROVEMENT PERMIT / AUTHORIZATION TO CONSTRUCT / OPERATION PERMIT / EXISTING SYSTEM INSPECTION

PERMIT# 8[illegible]533 PIN# 379 538 1811 DATE 8/29/00

OWNER OR CONTRACTOR J. Kelleather + Assoc. PHONE: Business (704) 876-6847 Home

ADDRESS PO Box 6286 Statesville NC

LOCATION Old Mt, on Rt just Past Miracle Farm Rd

SUBDIVISION Stoney Dell BLOCK / SECTION 1 LOT 3 LOT AREA .52 SITE CLASS PS DESIGN FLOW 360 L.T.A.R. .3

Septic Tank: 1000 Gallons; STB 1007 Date 8/11/00
Pump Tank: Gallons; PT Date
Pump Make: Model Serial No.
Nitrification Field: No Fields 1 Square Feet 900' Linear Feet 300'
No Lines 7@43' Trench Width 36" Max Trench Bottom Depth 24"

[X] New System [ ] Repair System Type: I, II, (III), IV, V, VI
System Description: Gravity 25% Reduction
Repair System Description: Gravity / Pump 25%
Maintenance Agreement Required: [ ] Yes [X] No
Gravel Depth —
[ ] Slab [X] Crawl Space [ ] Basement w/plumbing [ ] Basement wo/plumbing


[ ] House/Mod. Home No. Bedrooms 3
[X] Mobile Home No. Bathrooms 2
[ ] Business No. Employees
[ ] Other

Water Supply: [ ] Individual [X] Public [X] Community


Comments/Conditions: Drop Boxes

Comments /Conditions:

INITIAL SITE SKETCH

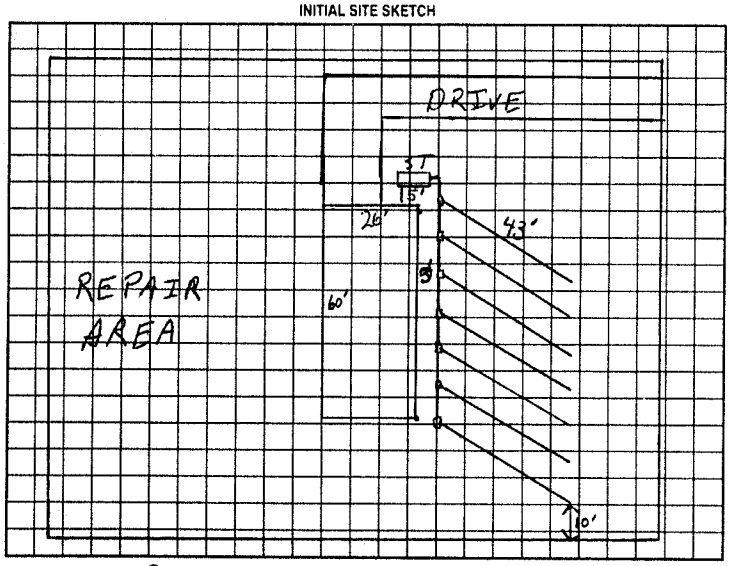

AS BUILT SKETCH

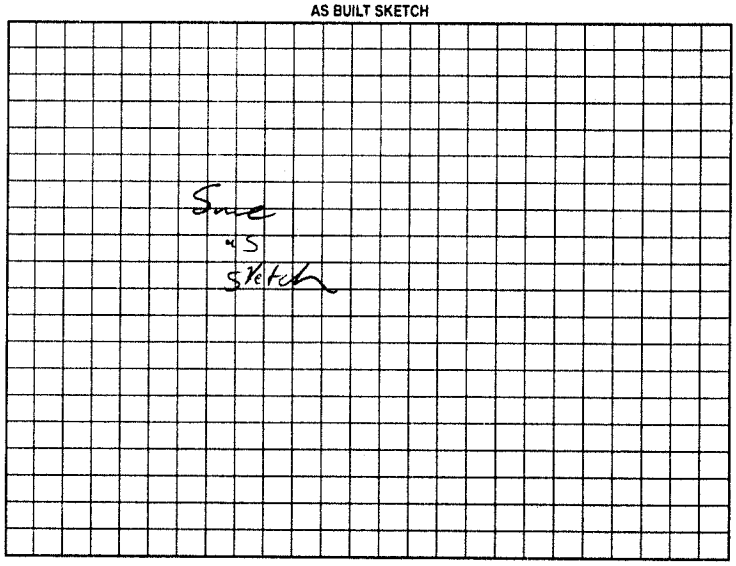

Permit can be suspended or revoked if any false information is supplied toward securing the permit/any unauthorized changes are made to the site/any unauthorized changes are made in the installation of the system. Improvement Permit with plat valid without expiration. Improvement Permit with site plan valid for sixty months. Authorization to Construct is valid for a period equal to that of Improvement Permit – not to exceed sixty months.

Signed: date 8/30/00 Installed by: Tommy Cothran

Improvement Permit by: RSI date 8/29/00 Operation Permit by: C. date 9/18/00

Authorization to Construct by: RSI date 8/29/00 Existing System Inspection by: date

HEALTH DEPT. COPY: WHITE OWNER COPY (FINAL): YELLOW OWNER COPY (INITIAL): PINK