IREDELL COUNTY HEALTH DEPARTMENT

STATESVILLE 704-878-5305 MOORESVILLE 704-664-5281

IMPROVEMENT PERMIT / AUTHORIZATION TO CONSTRUCT / OPERATION PERMIT / EXISTING SYSTEM INSPECTION

PERMIT# 92667 PIN# 3795 474234 DATE 11/1/00

OWNER OR CONTRACTOR Sun-wood PHONE: Business 5720922 Home

ADDRESS PO Box 5877 Statesville NC 28687

LOCATION Old Mtn. Rd just past Miracle Farm Rd on Rt

SUBDIVISION Stoney Dell BLOCK / SECTION — LOT #2 LOT AREA 0.554c SITE CLASS PS DESIGN FLOW 360 L.T.A.R. 0.5

Septic Tank: 1000 Gallons; STB 1012 Date 10/29/00
Pump Tank: Gallons; PT Date
Pump Make: Model Serial No
Nitrification Field: No Fields 1 Square Feet 1200 Linear Feet 400
No Lines 6@67' Trench Width 36" Max Trench Bottom Depth 36" Gravel Depth 12"

☒ New System ☐ Repair System Type: I (II) III. IV. V. VI
System Description: Grav. Conv.
Repair System Description: Same
Maintenance Agreement Required: ☐ Yes ☒ No


☐ House/Mod. Home ☒ Mobile Home ☐ Business ☐ Other
No. Bedrooms 3 No. Bathrooms 2 No. Employees
☐ Slab ☒ Crawl Space ☐ Basement w/plumbing ☐ Basement wo/plumbing

Water Supply: ☐ Individual ☒ Public ☐ Community

Comments/Conditions:

Comments/Conditions: ① Keep H2O Line 10' off any part of system
② PolyLok Filter

INITIAL SITE SKETCH

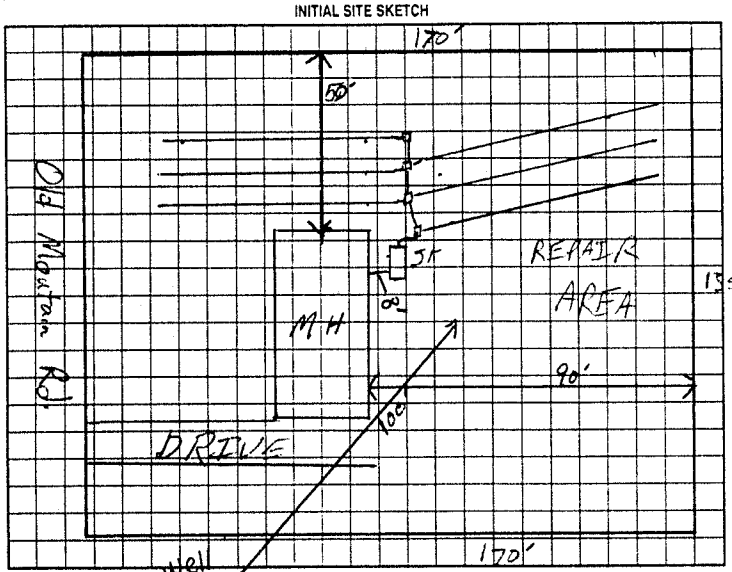

AS BUILT SKETCH

INSTALLED AS SHOWN

Permit can be suspended or revoked if any false information is supplied toward securing the permit/any unauthorized changes are made to the site/any unauthorized changes are made in the installation of the system. Improvement Permit with plat valid without expiration. Improvement Permit with site plan valid for sixty months. Authorization to Construct is valid for a period equal to that of Improvement Permit – not to exceed sixty months.

Signed: [signature] date 11/3/00 Installed by: Tommy Cathrea

Improvement Permit by: [signature] REHS date 11/1/00 Operation Permit by: Joe Dunn RS LSS/A. Lorne Cook/[illegible] date 12-29-00

Authorization to Construct by: [signature] REHS date 11/1/00 Existing System Inspection by: date

HEALTH DEPT. COPY: WHITE OWNER COPY (FINAL): YELLOW OWNER COPY (INITIAL): PINK