IREDELL COUNTY HEALTH DEPARTMENT

STATESVILLE 704-878-5305 MOORESVILLE 704-664-5281

IMPROVEMENT PERMIT / AUTHORIZATION TO CONSTRUCT / OPERATION PERMIT / EXISTING SYSTEM INSPECTION

PERMIT# 095397 PIN# 3795 38 7811 DATE 4/16/01

OWNER OR CONTRACTOR Jenkins + Williams PHONE: Business (704) 872-0922 Home —

ADDRESS P.O. Box 5722 Statesville, N.C. 28687

LOCATION I-40 W, (R) Old Mtn Rd, (R) Stacy Dell

SUBDIVISION Stacy Dell BLOCK / SECTION II LOT 11 LOT AREA .74 SITE CLASS PS DESIGN FLOW 360 L.T.A.R. .3

Septic Tank: 1,000 Gallons: STB 1012 Date 3-3-01
Pump Tank: — Gallons; PT — Date —
Pump Make: — Model — Serial No —
Nitrification Field: No Fields 1 Square Feet 1,200 Linear Feet 400
No Lines 1 Trench Width 36" Max Trench Bottom Depth 30" Gravel Depth 12"

[X] New System [ ] Repair System Type: [O] III IV V VI
System Description: Organic Conv.
Repair System Description: Conventional 25% Reduction
Maintenance Agreement Required: [ ] Yes [X] No
[ ] Slab [X] Crawl Space [ ] Basement w/plumbing [ ] Basement wo/plumbing


[ ] House/Mod. Home No. Bedrooms 3
[X] Mobile Home No. Bathrooms 2
[ ] Business No. Employees —
[ ] Other —

Water Supply: [ ] Individual [X] Public [ ] Community


Comments/Conditions: ① Remove Old Field Terraces in Septic System Area ② Install liner on Contour

Comments/Conditions: Okay to Install 5-80ft lines per Health Dept. - w/ - Poly lok Filter Installed - Septic Tank Marker Installed

INITIAL SITE SKETCH

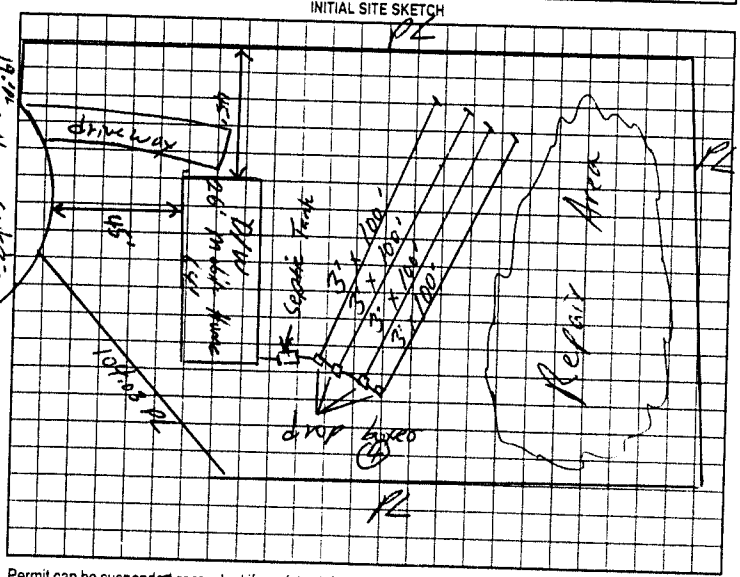

AS BUILT SKETCH Not to Scale

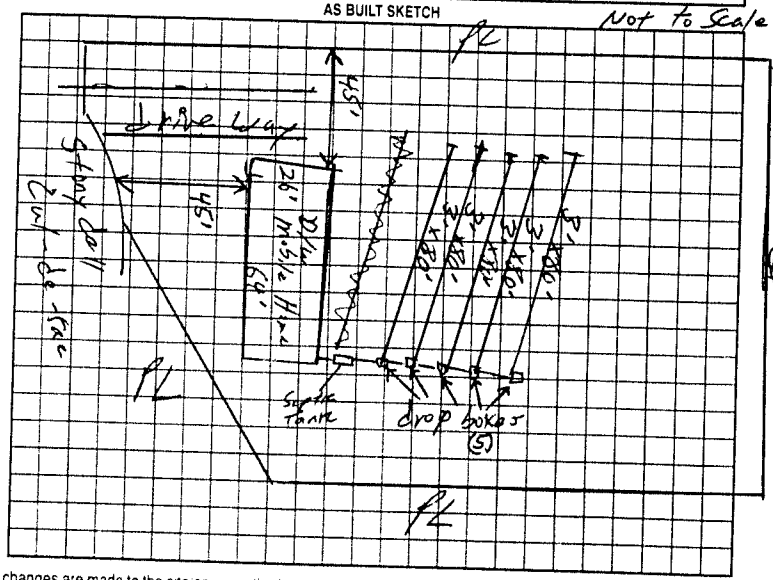

Permit can be suspended or revoked if any false information is supplied toward securing the permit/any unauthorized changes are made to the site/any unauthorized changes are made in the installation of the system. Improvement Permit with plat valid without expiration, Improvement Permit with site plan valid for sixty months. Authorization to Construct is valid for a period equal to that of Improvement Permit – not to exceed sixty months.

Signed: [signature] date 5/4/01

Improvement Permit by: William O. Johnson RSI date 4/16/01

Authorization to Construct by: William O. Johnson RSI date 4/16/01

Installed by: Joey Cothern

Operation Permit by: William O. Johnson date 6/19/01

Existing System Inspection by: — date —

HEALTH DEPT COPY WHITE OWNER COPY (FINAL) YELLOW OWNER COPY (INITIAL) PINK