IREDELL COUNTY HEALTH DEPARTMENT

STATESVILLE 704-878-5305 MOORESVILLE 704-664-5281

IMPROVEMENT PERMIT / AUTHORIZATION TO CONSTRUCT / OPERATION PERMIT / EXISTING SYSTEM INSPECTION

PERMIT# 077569 PIN# 3795 47 6132 DATE 11-10-98

OWNER OR CONTRACTOR STIKELEATHER & ASSOC. PHONE: Business 585-2728 Home

ADDRESS 267 LINDSEY FARM ROAD, STONY POINT, NC 28678

LOCATION I-40 W TR OLD MOUNTAIN ROAD, ON RIGHT JUST PAST NEW STERLING CHURCH ROAD

SUBDIVISION JOE M. JENKINS BLOCK / SECTION LOT 1 LOT AREA 0.493 AC SITE CLASS. PS DESIGN FLOW 360 L.T.A.R. 0.33 GPD/FT²

Septic Tank: 1000 Gallons; STB 825 Date 10-1-98

Pump Tank: Gallons; PT Date

Pump Make: Model Serial No.

Nitrification Field: No Fields Square Feet 1080 Linear Feet 360

No Lines FOUR Trench Width 36" Max Trench Bottom Depth 36" Gravel Depth 12"

☑ New System ☐ Repair System Type: I, II, III, IV, V, VI

System Description: CONVENTIONAL GRAVITY

Repair System Description: PPBPS, PUMP/GRAV

Maintenance Agreement Required: ☐ Yes ☑ No

☐ House/Mod. Home ☑ Mobile Home ☐ Business ☐ Other

No. Bedrooms 3 No. Bathrooms 2 No. Employees


☐ Slab ☑ Crawl Space ☐ Basement w/plumbing ☐ Basement wo/plumbing

Water Supply: ☑ Individual ☐ Public ☐ Community WELL


Comments:/Conditions: ① KEEP SYSTEM MAXIMUM FEASIBLE DISTANCE (95 FEET) FROM WELL. ② NO CUTTING OR FILLING OF SOIL OVER AREA OF DRAINFIELD.

Comments:/Conditions:

INITIAL SITE SKETCH SCALE: 1" = 40'

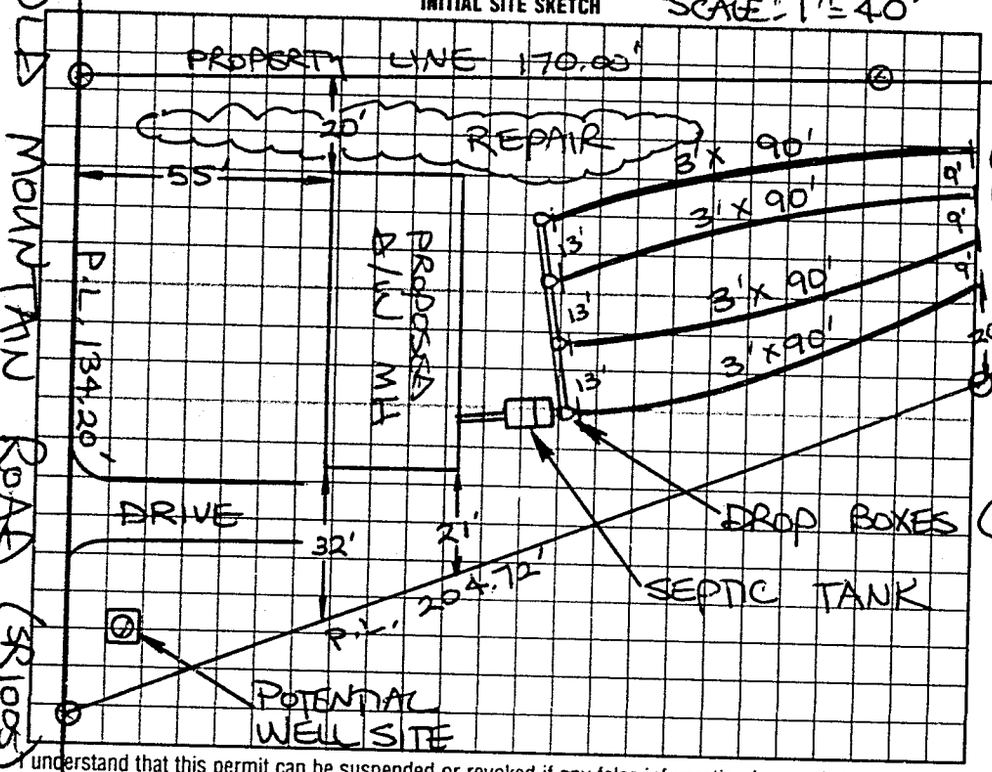

AS BUILT SKETCH

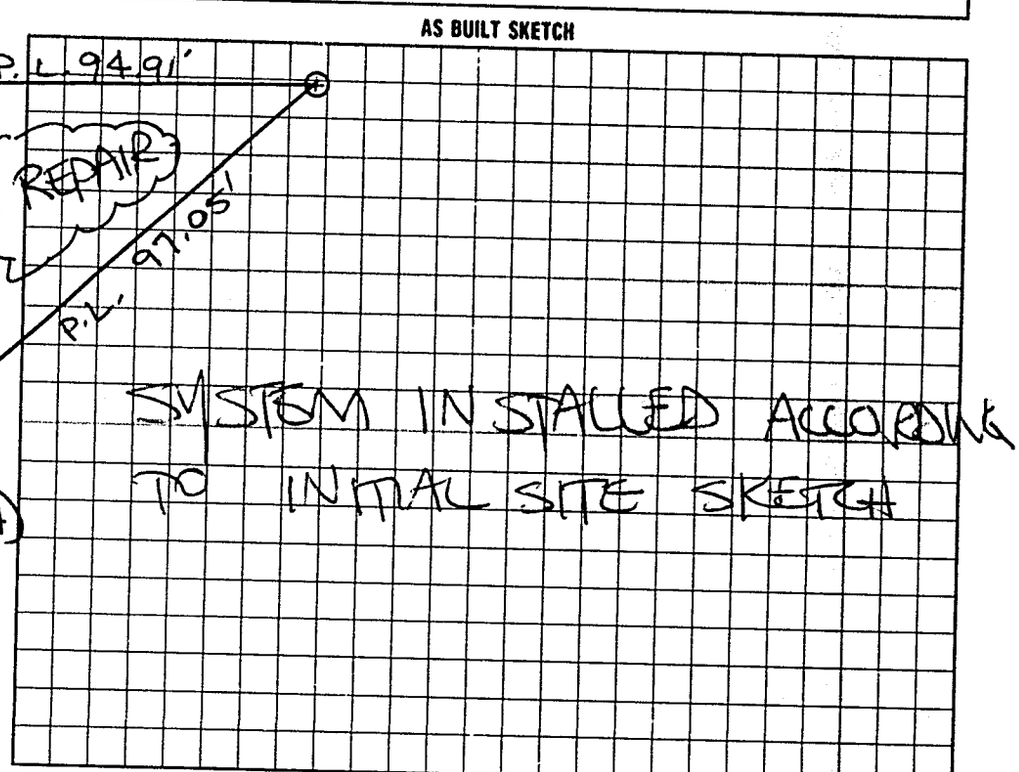

I understand that this permit can be suspended or revoked if any false information is supplied toward securing the permit/any unauthorized changes are made to the site/any unauthorized changes are made in the installation of the system. Improvement Permit with plat valid without expiration. Improvement Permit with site plan valid for sixty months. Authorization to Construct is valid for a period equal to that of Improvement Permit – not to exceed sixty months.

Signed: David Stikeleather

Improvement Permit by: STEVE HEDRICK date 11-10-98

Authorization to Construct by: STEVE HEDRICK date 11-10-98

Installed by: C & W GRADING

Operation Permit by: STEVE HEDRICK date 12-15-98

Existing System Inspection by date

HEALTH DEPT COPY: WHITE INSPECTION COPY (FINAL): GREEN OWNER COPY (FINAL): YELLOW INSPECTION COPY (INITIAL): PINK OWNER COPY (INITIAL): GOLD