IREDELL COUNTY HEALTH DEPARTMENT

STATESVILLE 704-878-5305 MOORESVILLE 704-664-5281

IMPROVEMENT PERMIT / AUTHORIZATION TO CONSTRUCT / OPERATION PERMIT / EXISTING SYSTEM INSPECTION

PERMIT# 094307 PIN# 3795 47 3773 DATE 2/9/01

OWNER OR CONTRACTOR JENKINS AND WILLIAMS PHONE: Business (704) 872-0922 Home

ADDRESS P.O. BOX 5877, STATESVILLE, NC 28677

LOCATION I-40 W TO OLD MTN. RD. (R), (R) STONEYDELL AT END OF CUL DE SAC

SUBDIVISION STONEYDELL BLOCK / SECTION LOT 9 LOT AREA .76 Ac. SITE CLASS PS DESIGN FLOW 360 GPD L.T.A.R. .75

Septic Tank: 1000 Gallons; STB 1012 Date 10-21-00
Pump Tank: Gallons; PT Date
Pump Make: Model Serial No.
Nitrification Field: No Fields 1 Square Feet 1028 Linear Feet 342'
No Lines 3 Trench Width 3' Max Trench Bottom Depth 30"

☑ New System ☐ Repair System Type: I (II) III. IV. V. VI
System Description: CONVENTIONAL
Repair System Description: 25% Reduction / Gravity
Maintenance Agreement Required: ☐ Yes ☑ No
Gravel Depth


☐ House/Mod. Home ☑ Mobile Home ☐ Business ☐ Other
No. Bedrooms 3 No. Bathrooms 2 No. Employees
☐ Slab ☑ Crawl Space ☐ Basement w/plumbing ☐ Basement wo/plumbing

Water Supply: ☐ Individual ☑ Public ☐ Community


Comments/Conditions: ① NO CUTTING OR FILLING OVER DRAINFIELD/REPAIR AREAS ② KEEP ALL DRAINS AWAY FROM DRAINFIELD/REPAIR AREAS ③ MAINTAIN NOTED SETBACKS ④ INSTALL DRAINLINES UNIFORM AND ON CONTOUR.

Comments/Conditions: - Poly Lok Filter Installed - Septa Tank Marker Installed.

INITIAL SITE SKETCH

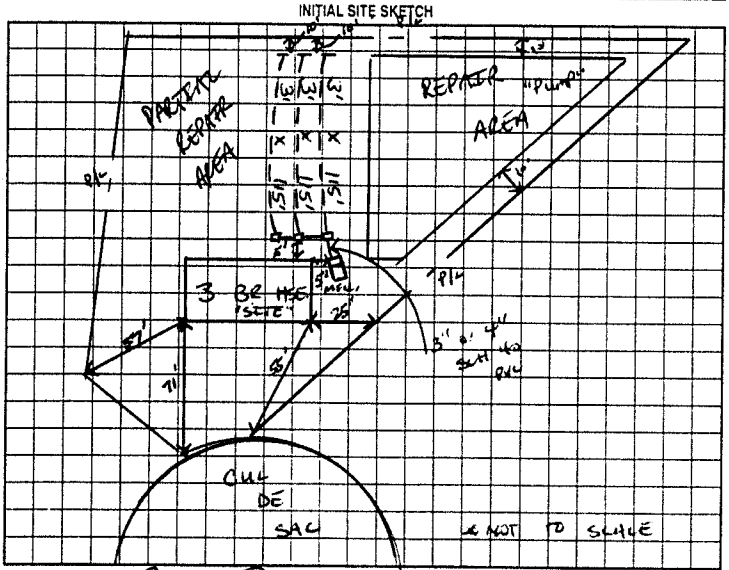

AS BUILT SKETCH

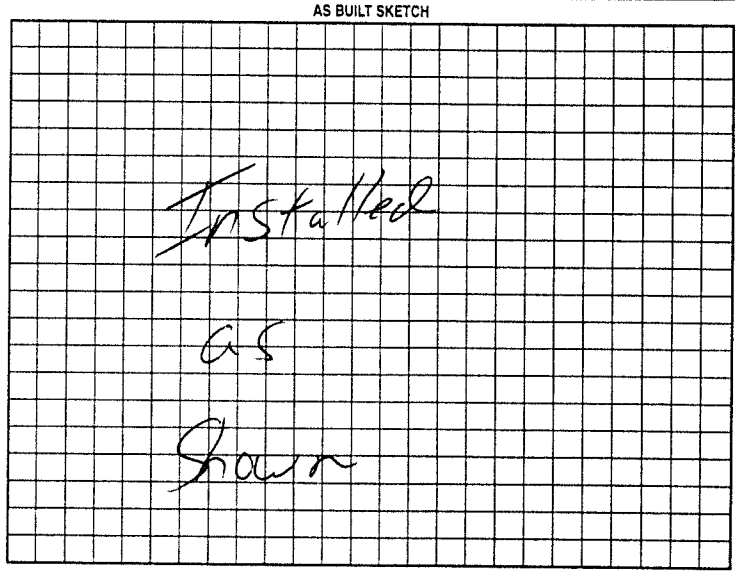

Permit can be suspended or revoked if any false information is supplied toward securing the permit/any unauthorized changes are made to the site/any unauthorized changes are made in the installation of the system. Improvement Permit with plat valid without expiration. Improvement Permit with site plan valid for sixty months. Authorization to Construct is valid for a period equal to that of Improvement Permit – not to exceed sixty months.

Signed: date 2/19/01

Improvement Permit by: date 2/9/01

Authorization to Construct by: date 2/9/01

Installed by: Tommy Cothren

Operation Permit by: William O. Johnson date 2/28/01

Existing System Inspection by: date

HEALTH DEPT. COPY: WHITE OWNER COPY (FINAL): YELLOW OWNER COPY (INITIAL): PINK