IREDELL COUNTY HEALTH DEPARTMENT

STATESVILLE 704-878-5305 ✓ MOORESVILLE 704-664-5281

IMPROVEMENT PERMIT / AUTHORIZATION TO CONSTRUCT / OPERATION PERMIT / EXISTING SYSTEM INSPECTION

PERMIT# 095003 PIN# 3795381811 DATE 3/15/01

OWNER OR CONTRACTOR Sunwood Builders PHONE: Business (704) 872-0928 Home —

ADDRESS P.O. Box 5877 Statesville N.C. 28687

LOCATION I-40 W, (R) 018 mtn. Rd, (R) on Stonydell 4th end on Right

SUBDIVISION Stonydell BLOCK / SECTION — LOT 10 LOT AREA .86 Ac SITE CLASS PS DESIGN FLOW 360 L.T.A.R. .3

Septic Tank: 1,000 Gallons; STB 1012 Date 8-14-01
Pump Tank: — Gallons; PT — Date —
Pump Make: — Model — Serial No. —
Nitrification Field: No Fields 1 Square Feet 1,200 Linear Feet 400
No Lines 4@100' Trench Width 36" Max Trench Bottom Depth 30" Gravel Depth 12"

X New System ☐ Repair System Type: I (II) III IV V VI
System Description: Gravity, Conventional
Repair System Description: Gravity, Conventional
Maintenance Agreement Required: ☐ Yes X No

☐ House/Mod. Home No. Bedrooms 3
X Mobile Home No. Bathrooms 2
☐ Business No. Employees —
☐ Other —

☐ Slab X Crawl Space ☐ Basement w/plumbing ☐ Basement wo/plumbing


Water Supply: ☐ Individual X Public ☐ Community

Comments/Conditions: ① Install Lines on Contour ② Keep lines 10ft from property liner ③ Do not install when wet

1" = 60'

Comments/Conditions: - Septic Tank Marker Installed
Polylok Filter Installed

INITIAL SITE SKETCH

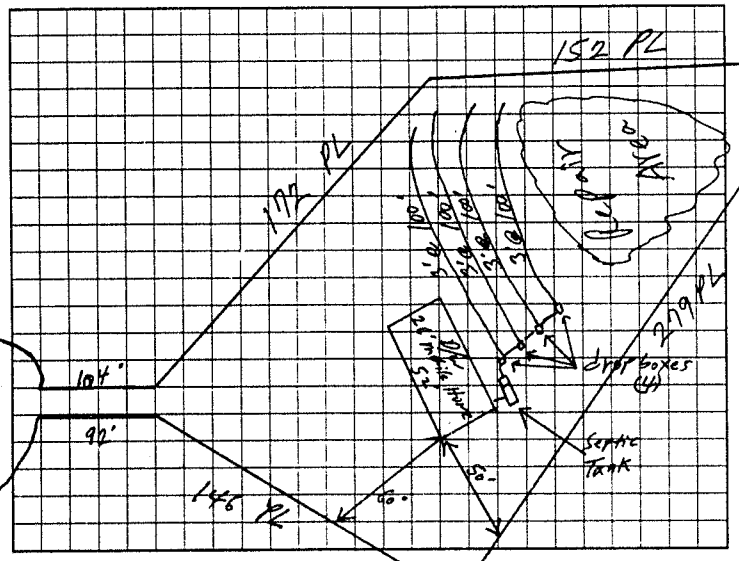

AS BUILT SKETCH

Installed as Shown per Initial Site Sketch

Permit can be suspended or revoked if any false information is supplied toward securing the permit/any unauthorized changes are made to the site/any unauthorized changes are made in the installation of the system. Improvement Permit with plat valid without expiration. Improvement Permit with site plan valid for sixty months. Authorization to Construct is valid for a period equal to that of Improvement Permit -- not to exceed sixty months.

Signed: [signature] date 3/16/01 Installed by: Joey Cathrine

Improvement Permit by: William O. Johnson, RSI date 3/15/01 Operation Permit by: William O. Johnson date 10/22/01

Authorization to Construct by: William O. Johnson, RSI date 3/15/01 Existing System Inspection by: — date —

HEALTH DEPT COPY WHITE OWNER COPY (FINAL) YELLOW OWNER COPY (INITIAL) PINK