IREDELL COUNTY HEALTH DEPARTMENT

STATESVILLE 704-878-5305 MOORESVILLE 704-664-5281

IMPROVEMENT PERMIT / AUTHORIZATION TO CONSTRUCT / OPERATION PERMIT / EXISTING SYSTEM INSPECTION

PERMIT# 14494 PIN# 3795-53-4960 DATE 2 October 07

OWNER OR APPLICANT PM Martin Construction / INC. PHONE: Business 704-872-5320 Home (704) 873-2220

ADDRESS 494 Ft. Rd. 60 Ren. Statesville, NC.

LOCATION Hwy 140 W Turn Rt. OMR - TL Nw Sterling Rd Corner of Westward.

SUBDIVISION Sterling Place BLOCK SECTION B LOT 2 LOT AREA 1.0 Acre SITE CLASS. PS DESIGN FLOW 360 gpd L.T.A.R. 0.3 ac/dwlg

Septic Tank: 1000 Gallons: STB 1000 Date 1-10-08

Pump Tank: Gallons: PT Date

Pump Make: Model Serial No.

Nitrification Field: No Fields 1 Square Feet 1000 Linear Feet 300

No Lines 4 Trench Width 36" Max Trench Bottom Depth 6'

☑ New System ☐ Repair ☐ Expansion System Type: I II III IV V VI

System Description: 25% Reduction

Repair System Description: 50% Reduction

Maintenance Agreement Required: ☐ Yes ☑ No

☑ House/Mod. Home No. Bedrooms 3

☐ Mobile Home No. Persons

☐ Business No. Employees

☐ Other

Water Supply: ☑ Individual ☐ Public ☐ Community


☐ Gravity ☐ Pressure ☐ Slab ☑ Crawl Space ☐ Basement w/plumbing ☐ Basement wo/plumbing

Comments:/Conditions:


Follow contour

Comments:/Conditions: Filter installed / Marker Attached.

INITIAL SITE SKETCH

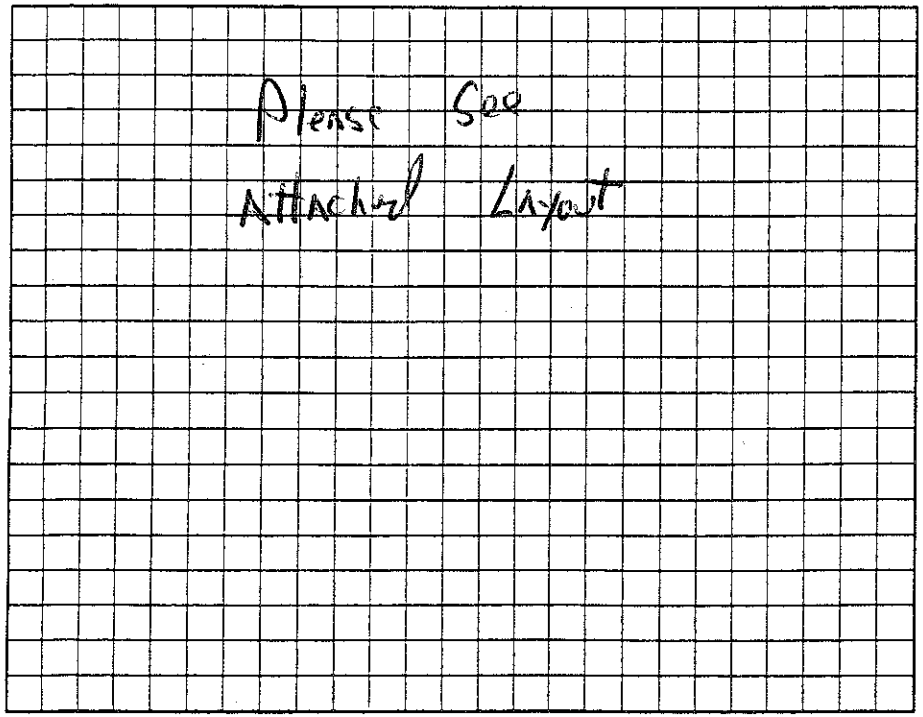

AS BUILT SKETCH

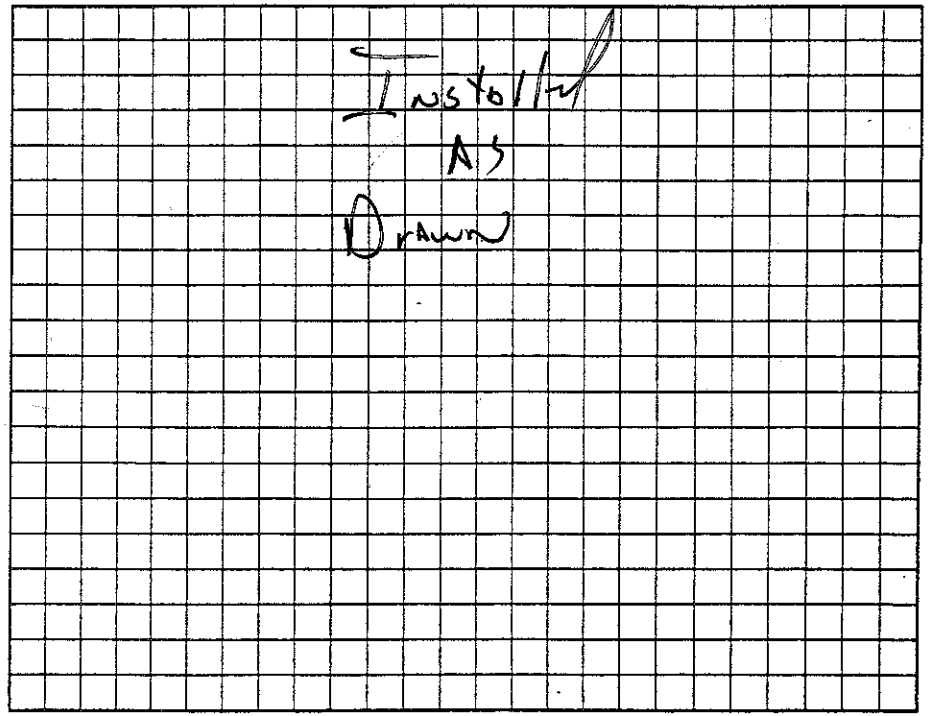

Permit can be suspended or revoked if any false information is supplied toward securing the permit/any unauthorized changes are made to the site/any unauthorized changes are made in the installation of the system. Improvement Permit with plat valid without expiration ☐ Improvement Permit with site plan valid for sixty months ☑ Authorization to Construct is valid for a period equal to that of Improvement Permit – not to exceed sixty months.

Signed: Tommy Morton date

Installed by: Joey Cothran


Improvement Permit by: R.S. date 2 October 07

Operation Permit by: R.S. date 8 April 08

Authorization to Construct by: R.S. date 2 October 07

Existing System Inspection by: date

HEALTH DEPT. COPY: WHITE OWNER COPY (FINAL): YELLOW OWNER COPY (INITIAL): PINK

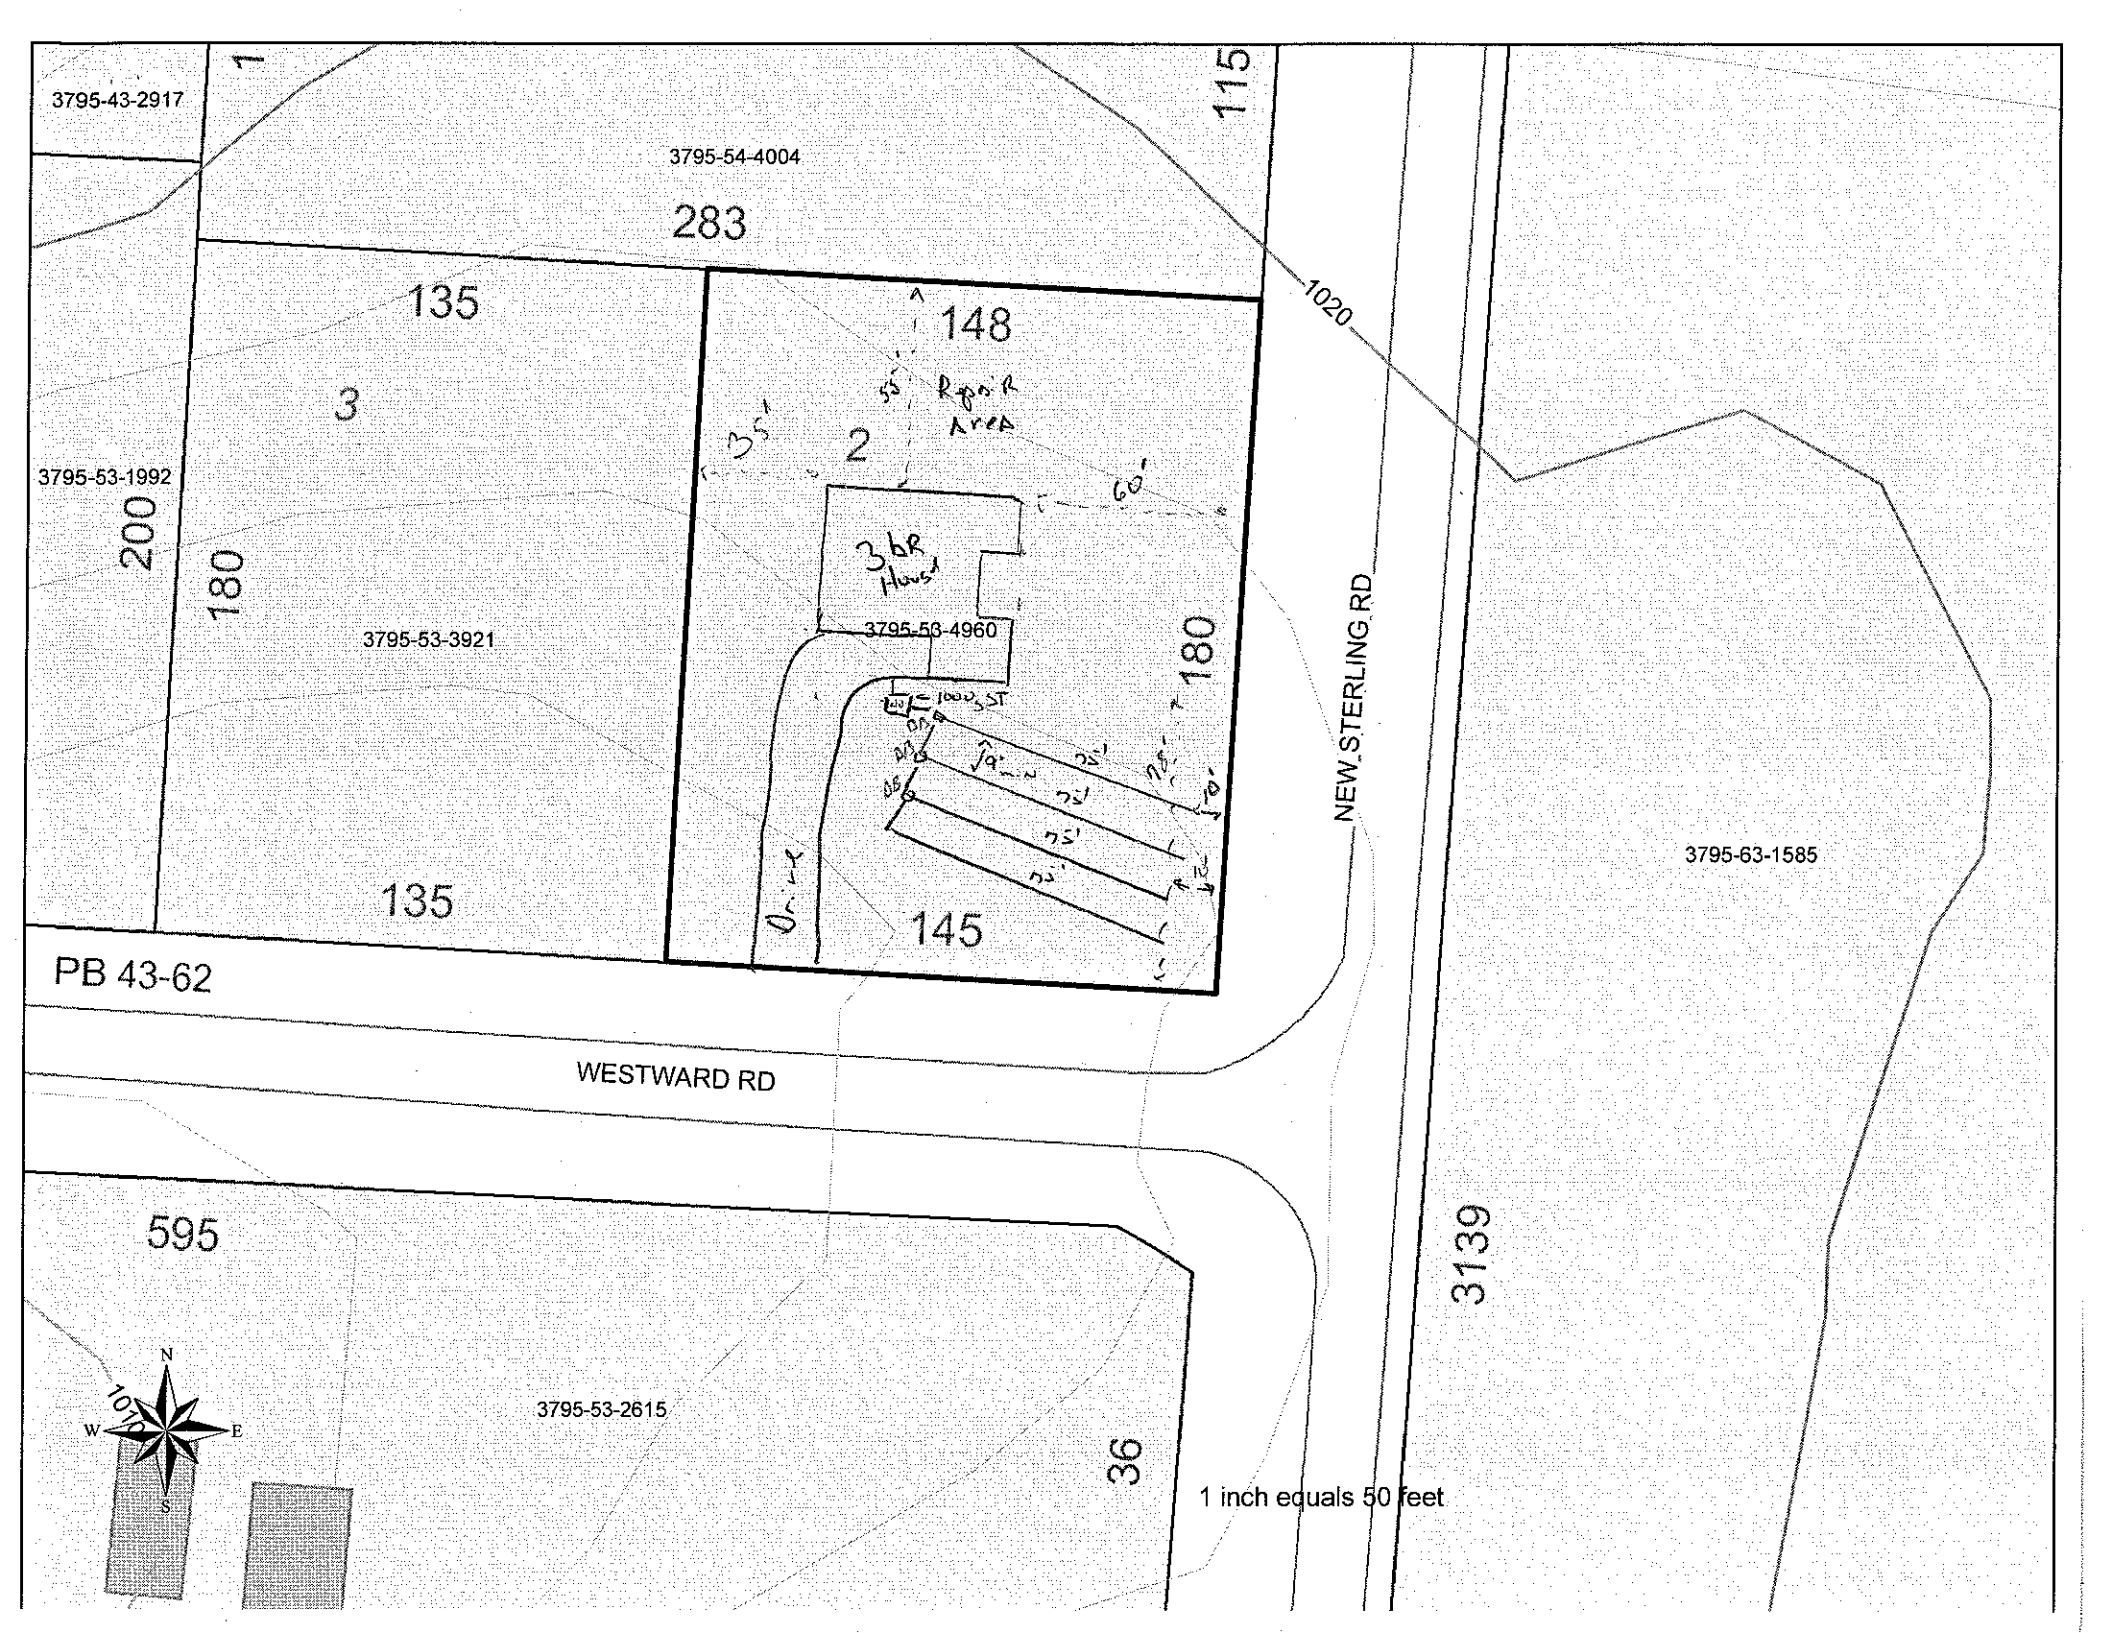
3795-43-2917
1
3795-54-4004
283
115
1020
135
148
3
2
3795-53-1992
200
180
3795-53-3921
3bR House
3795-53-4960
180
NEW STERLING RD
3795-63-1585
135
145
PB 43-62
WESTWARD RD
595
3795-53-2615
3139
36
N
W
E
S
1 inch equals 50 feet